


T.4S.R.2E.W.M.

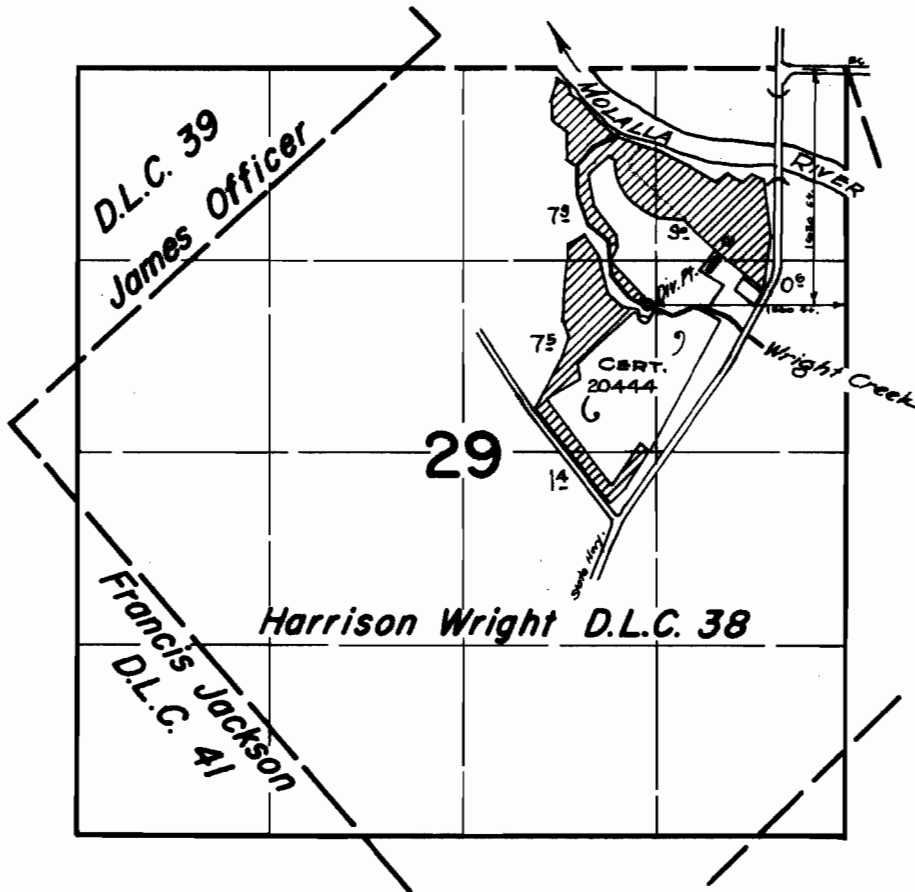

FINAL PROOF SURVEY
UNDER

Application No. 34727 Permit No. 27268
IN NAME OF

GILBERT O. KAPPLER

Surveyed April 12, 1965, by A. Jackson