


T.3S.R.1E.W.M.

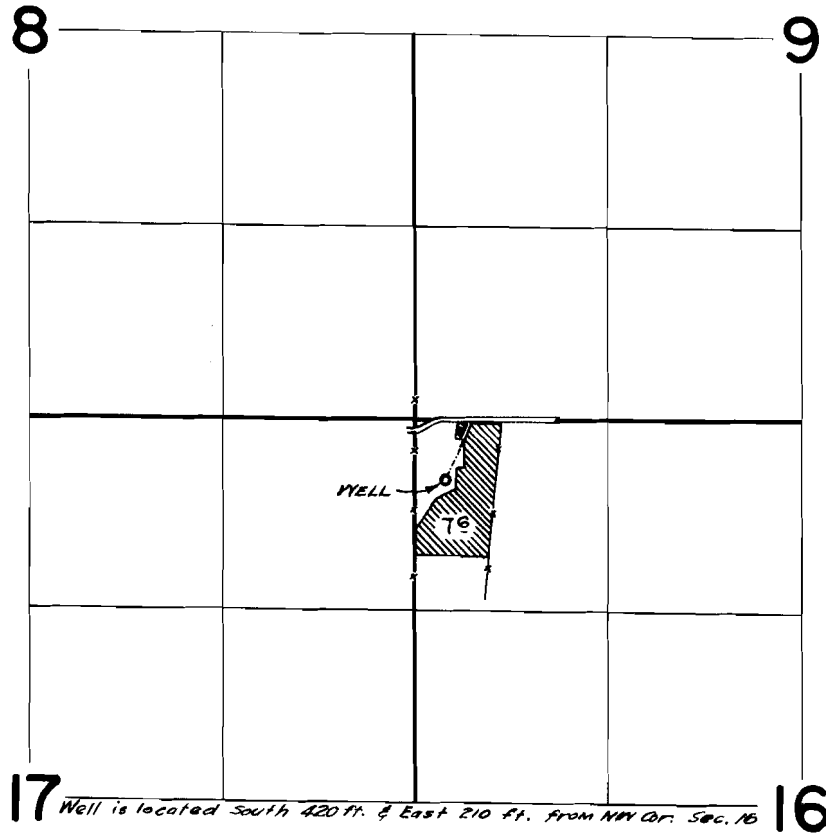

**FINAL PROOF SURVEY**  
UNDER

Application No. G-2086 Permit No. G-1916  
IN NAME OF

ROBERT WILLIAM KAISER

Surveyed April 23, 1965, by Spickard