


T.4S.R.1E.W.M.

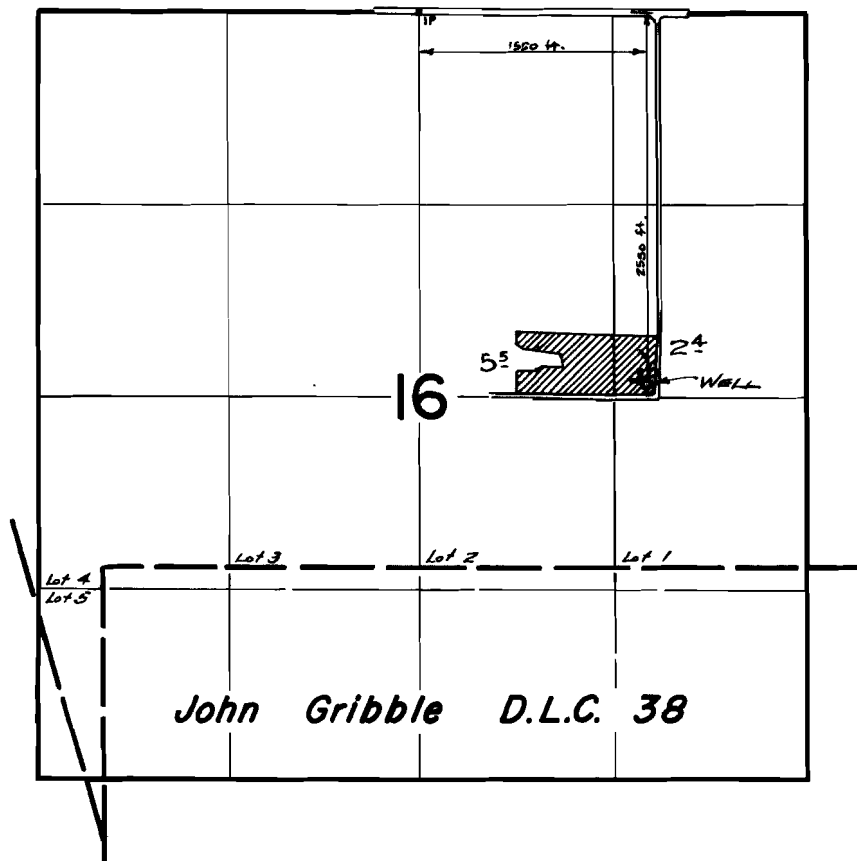

FINAL PROOF SURVEY
UNDER

Application No. **G-1882** Permit No. **G-1723**
IN NAME OF

A. J. KRZMARZICK

Surveyed *April 14 1965*, by *[Signature]*