


T.2S.R.1E.W.M.

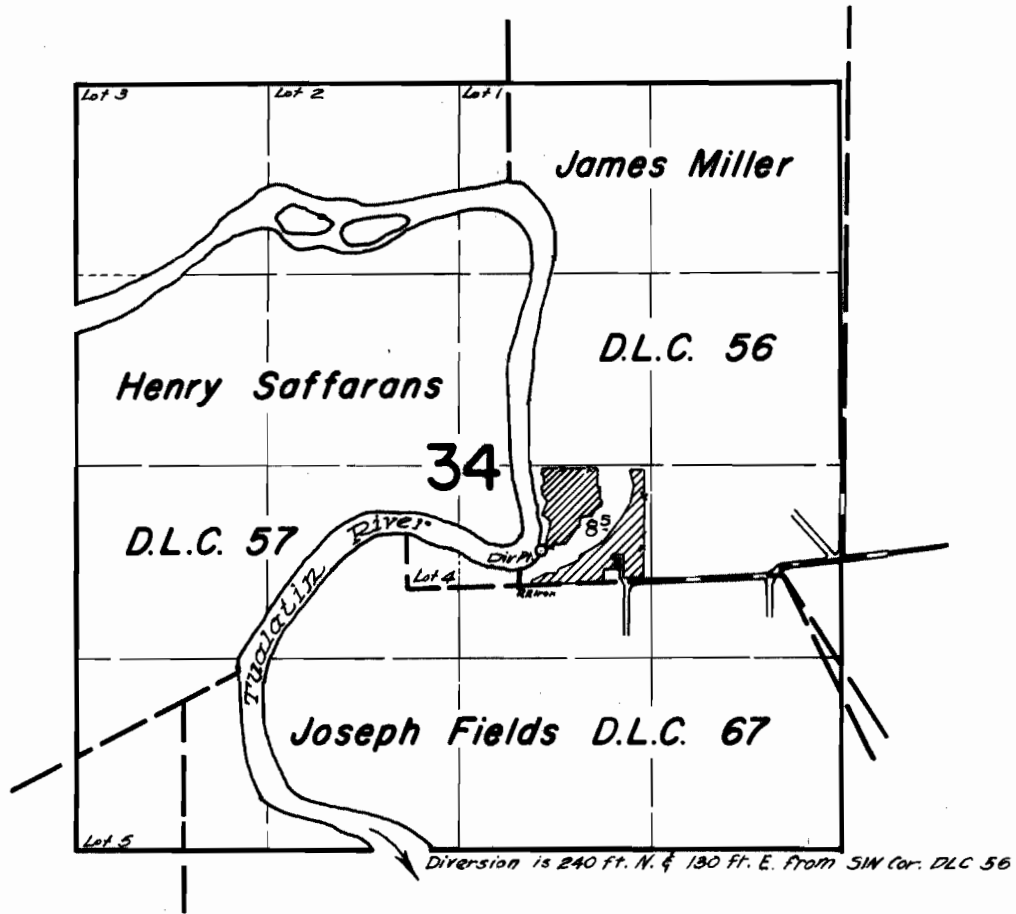

FINAL PROOF SURVEY
UNDER

Application No. 33623... Permit No. 26615...
IN NAME OF

R. W. LEONARD

Surveyed May 10, 1965, by *R. Jackson*