


T.3S.R.2E.W.M.

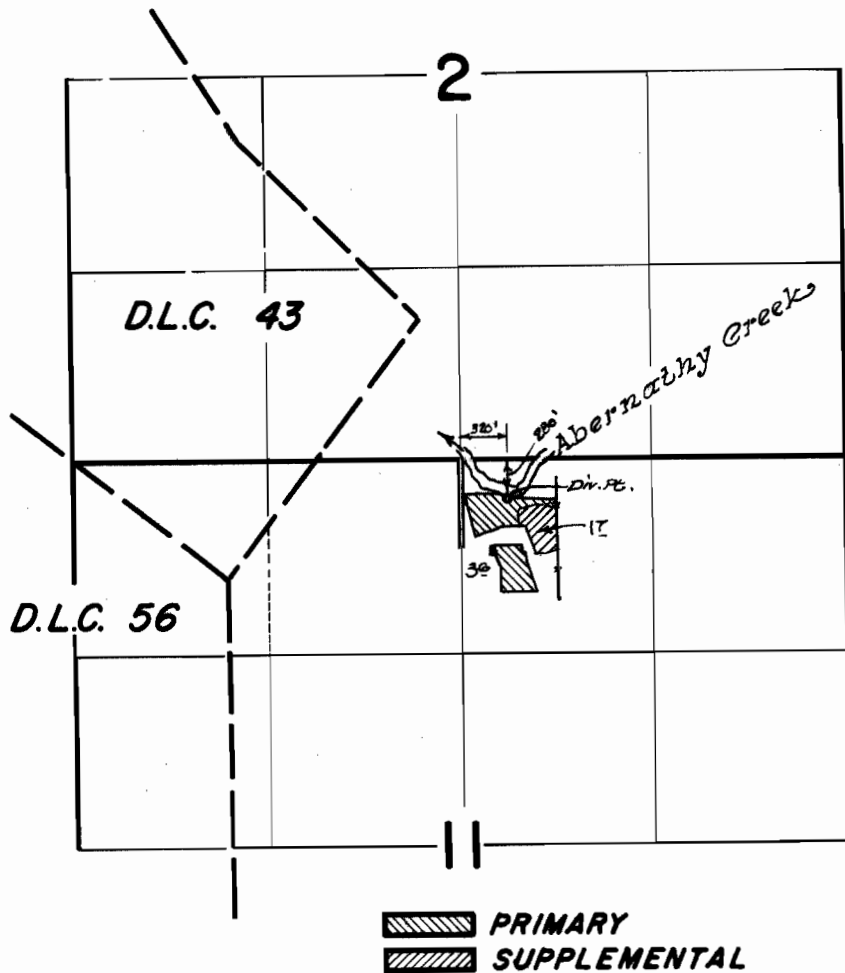

FINAL PROOF SURVEY UNDER

Application No. 37960... Permit No. 28309
IN NAME OF

H. L. MACK

Surveyed *May 12* 1905, by *R. Jackson*