


T.3S.R.1W.W.M.

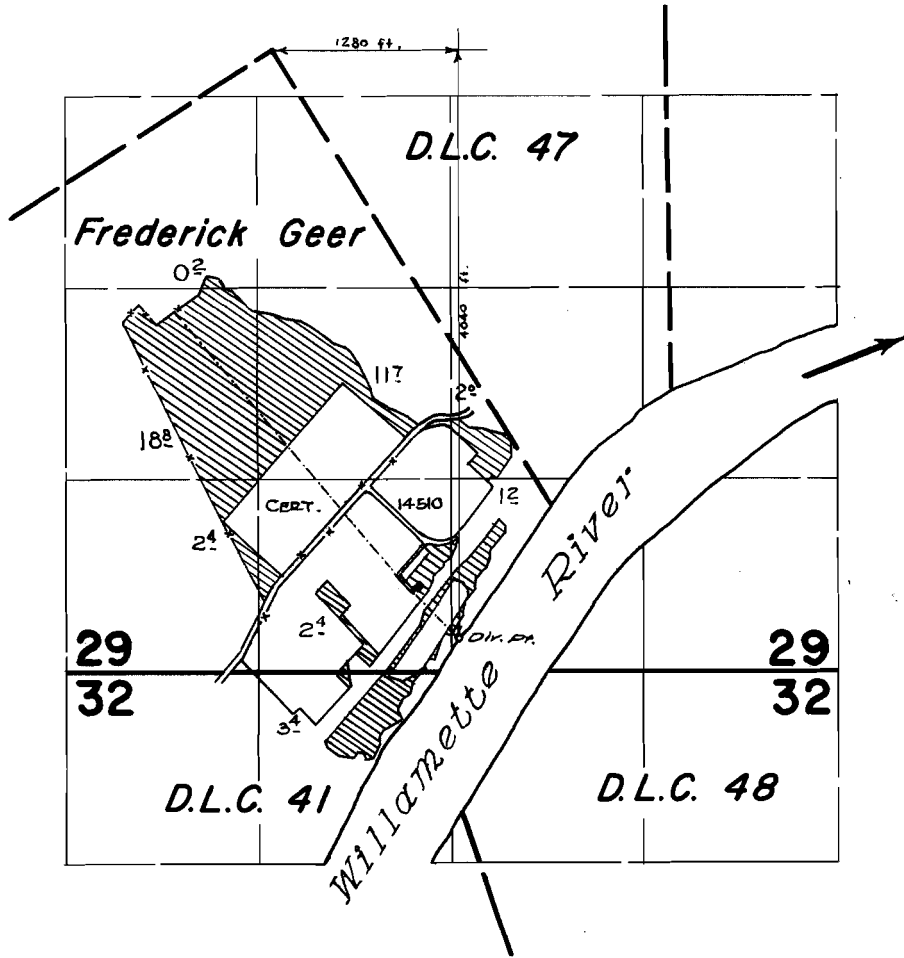

FINAL PROOF SURVEY UNDER

Application No. **40300** Permit No. **30058**
IN NAME OF

JAMES McDONALD

Surveyed August 20 1965, by

A. Jackson