


T.4S.R.3E.W.M.

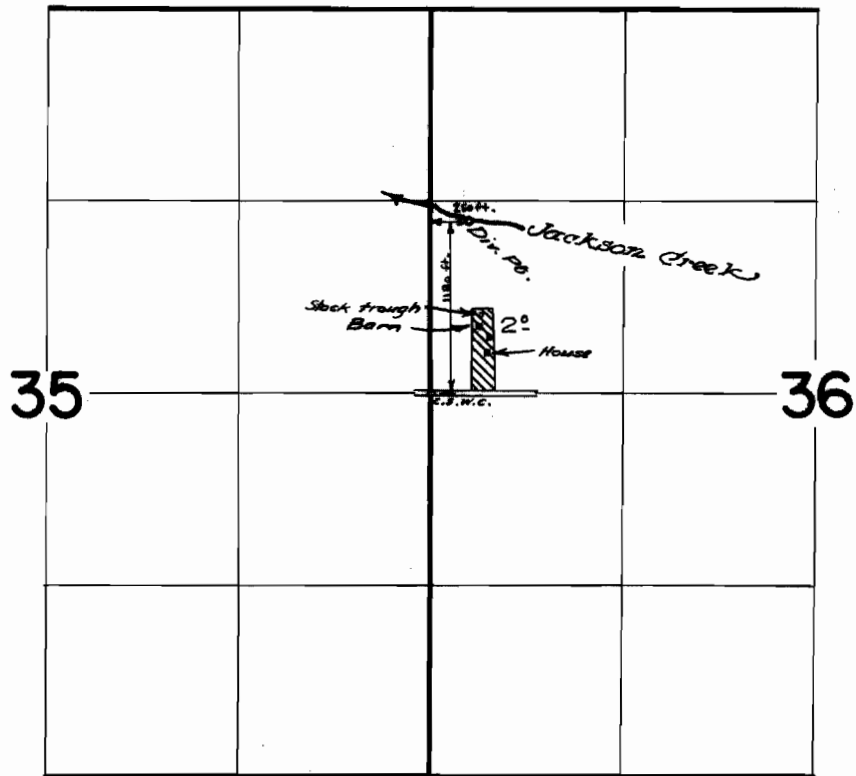

FINAL PROOF SURVEY
UNDER

Application No. 39717..... Permit No. 29547...
IN NAME OF

ROY & GERTRUDE A. MOONEY

Surveyed April 14, 1965, by *R. Jackson*