


T.6S.R.2E.W.M.

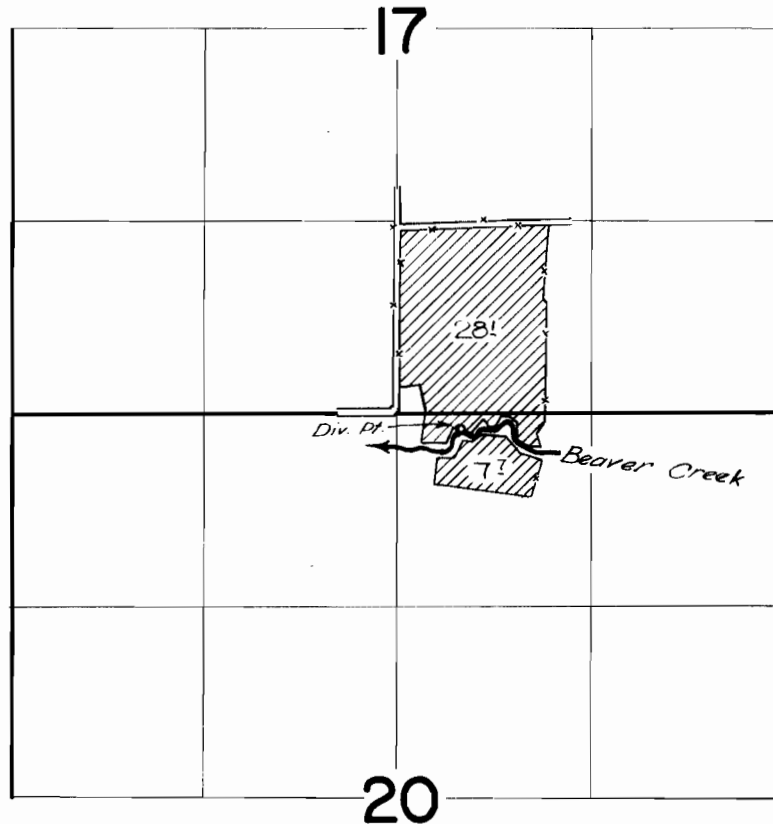

Diversion point is located 100 ft. south & 430 ft. east from north
¼ cor. Section 20

FINAL PROOF SURVEY
UNDER

Application No. **38859** Permit No. **28900**
IN NAME OF

EDWIN MUILENBURG

Surveyed *April 15, 1965*, by *[Signature]*