


T.5&6S.R.1E.W.M.

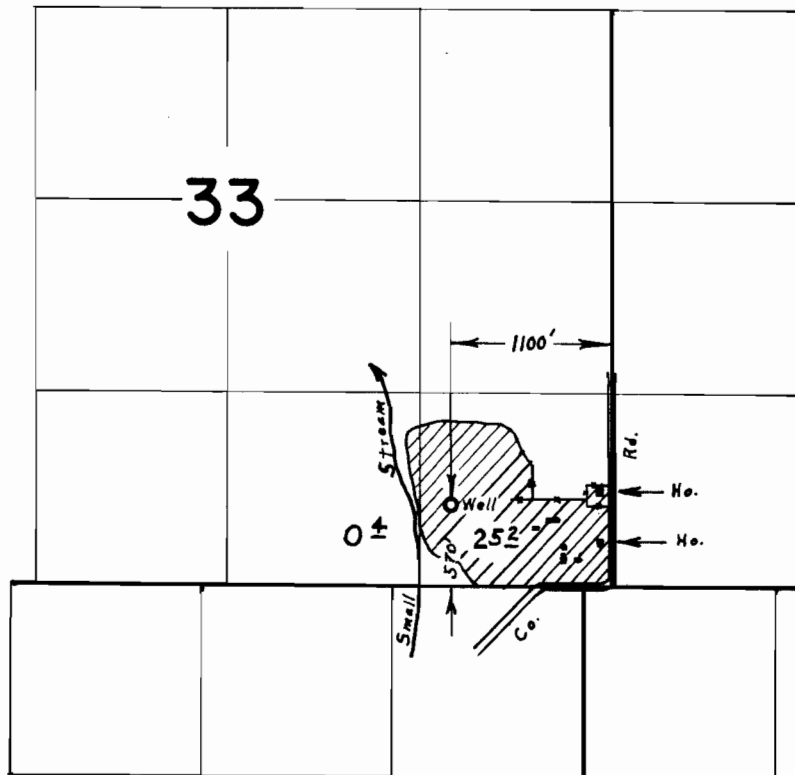

**FINAL PROOF SURVEY**  
UNDER

Application No. G-2647 Permit No. G-2447  
IN NAME OF

L. E. PAQUIN

Surveyed Oct. 18 1966, by L. E. Gould