


T.4S.R.4E.W.M.

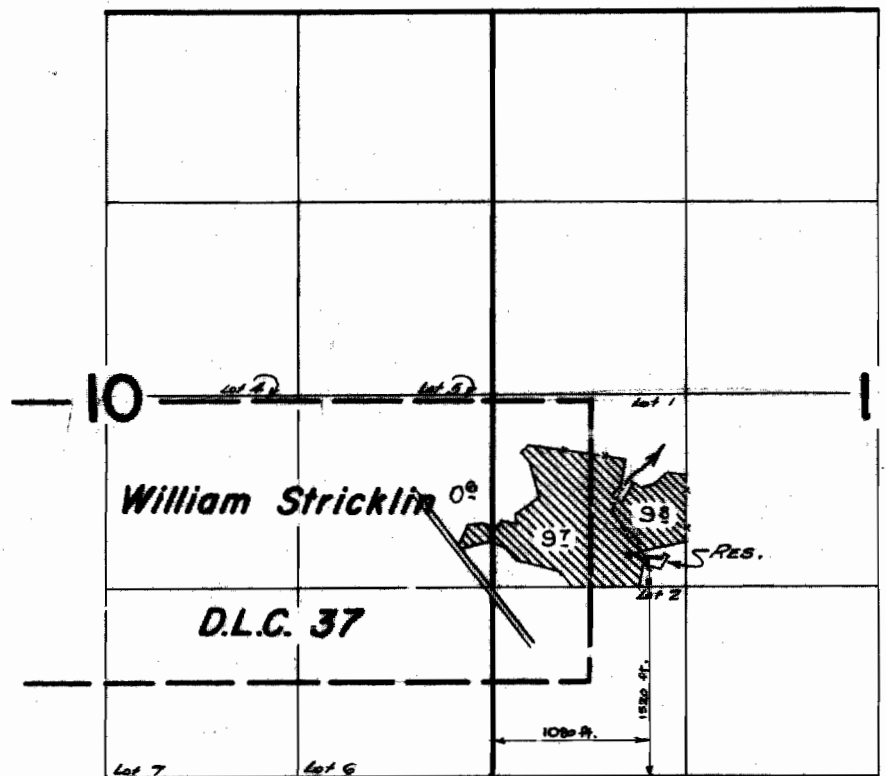

FINAL PROOF SURVEY

UNDER

Application No. **R-34498** Permit No. **R-2560**
34499 **27087**...
IN NAME OF

HOMER H. RAMBO

Surveyed April 15, 1965, by R. H. Jackson