


T.4S.R.4E.W.M.

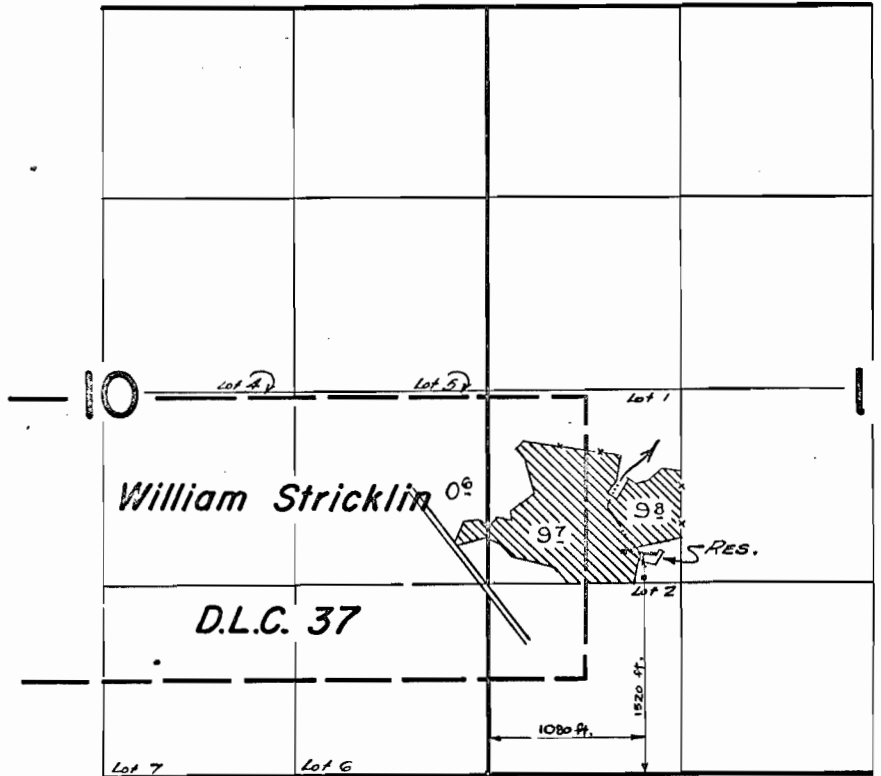

FINAL PROOF SURVEY
UNDER

R-34498 R-2560
Application No. 34499 Permit No. 27087
IN NAME OF

HOMER H. RAMBO

Surveyed April 15, 1965, by *K. Jackson*