


T.3S.R.1W.W.M.

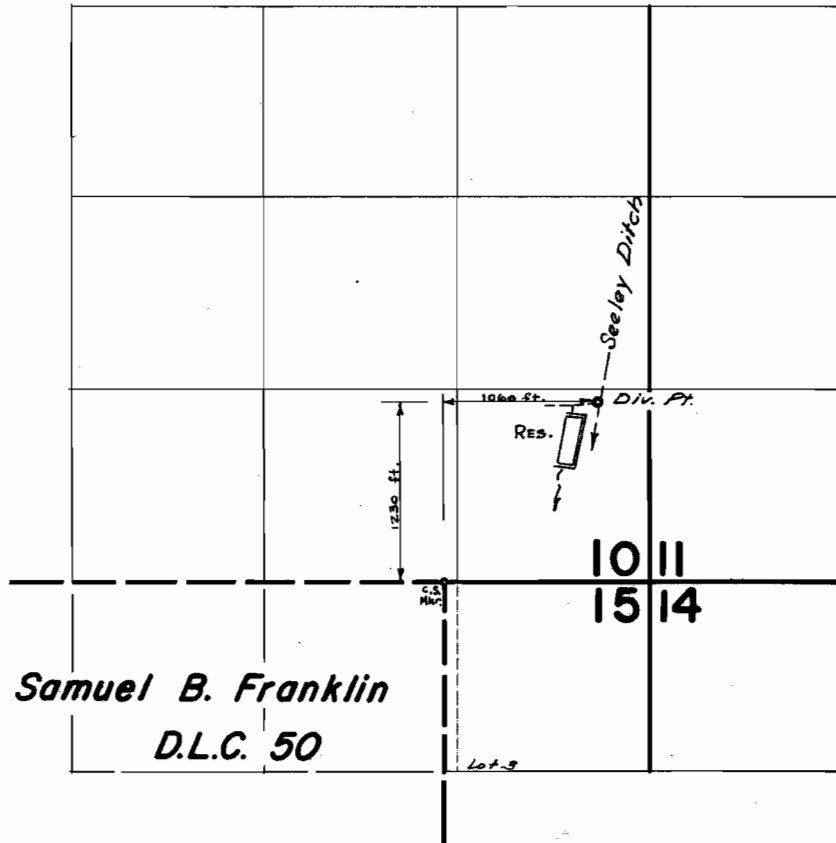

FINAL PROOF SURVEY UNDER

R-39038 R-3692
Application No. 39039 Permit No. 29074
IN NAME OF

EMERSON SIMS

Surveyed *May 13*, 1965, by *R. Jackson*