


# T.5S.R.2E.W.M.

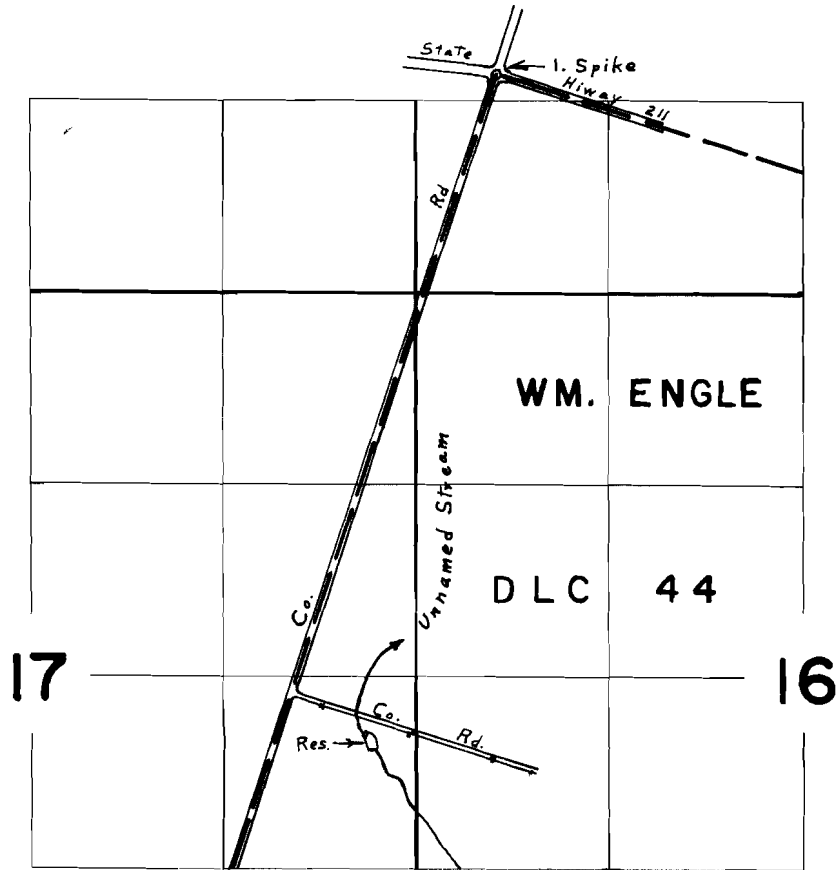

## FINAL PROOF SURVEY UNDER

Application No. *R-40069*. Permit No. *R-4505*  
IN NAME OF

**WILLIAM X. YOUNG**

Surveyed *Sept. 30, 1966*, by *L. E. Gould*