


T.24S.R.13W.W.M.

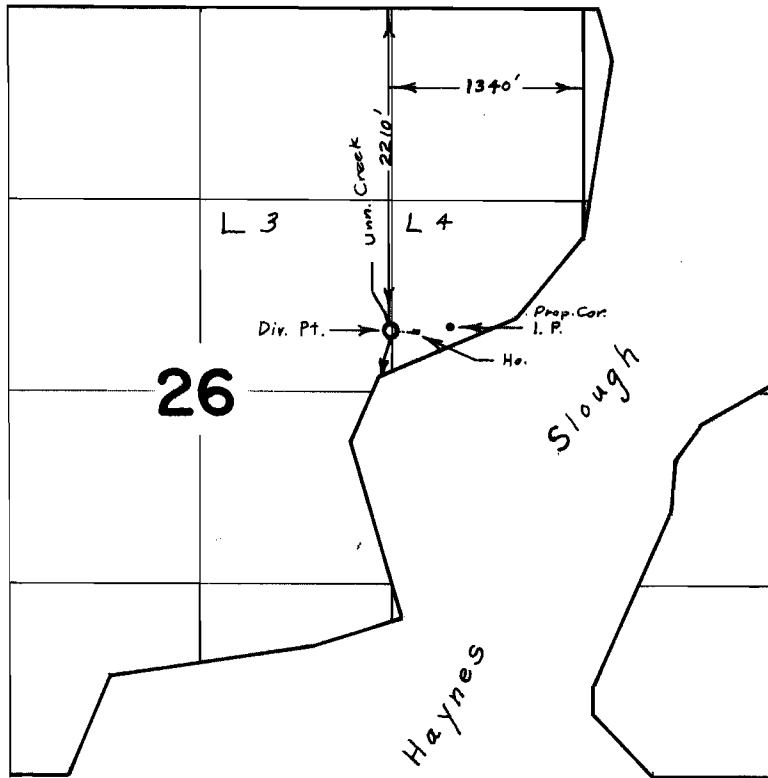

FINAL PROOF SURVEY UNDER

Application No. 39232 Permit No. 29232
IN NAME OF

BURTON ANDERSON

Surveyed Sept. 16, 1966, by L. E. Gould