


T.27S.R.12&13W.W.M.

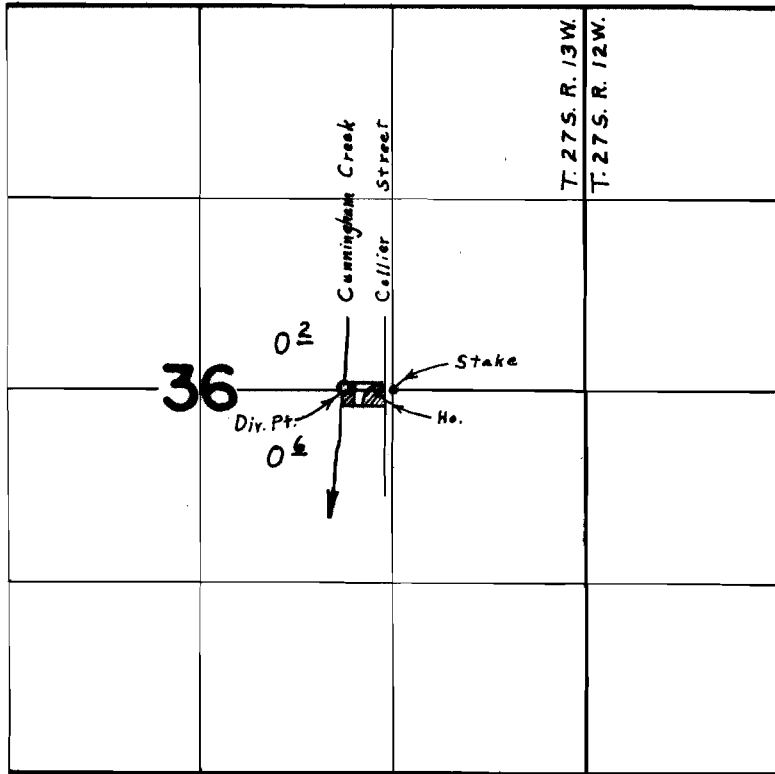

Div. Pt. Located 10' N. & 330' W. From the NE. Cor. N.W. $\frac{1}{4}$, S.E. $\frac{1}{4}$, Sec. 36

FINAL PROOF SURVEY UNDER

Application No. 41951 Permit No. 31190
IN NAME OF

DONALD P. & HELEN F. CARVER

Surveyed Oct. 10, 1966, by L. E. Gould