


T.23S.R.128&13W.W.M.

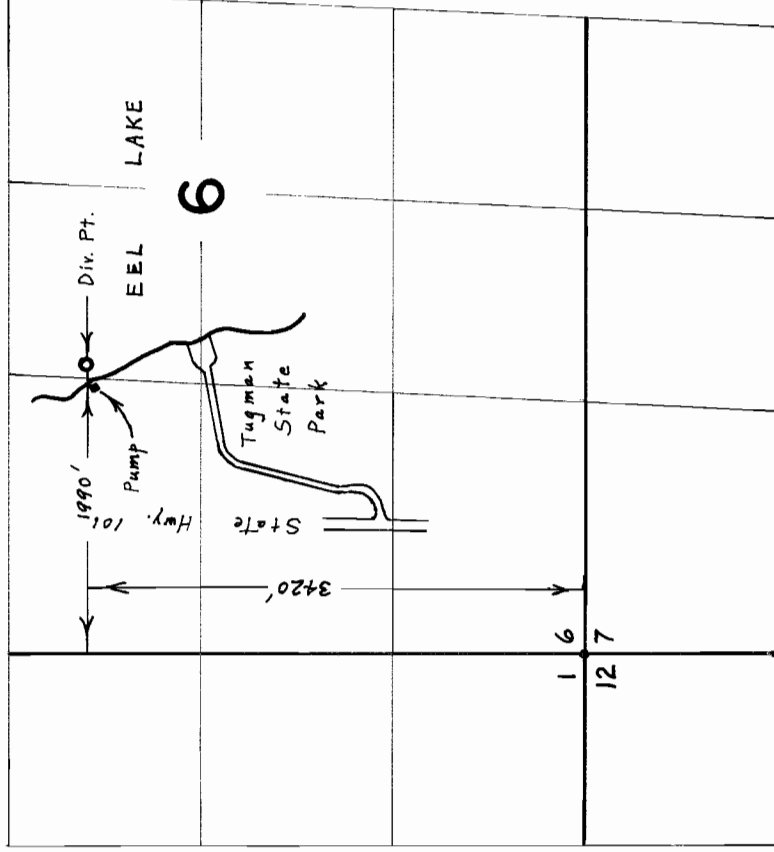

FINAL PROOF SURVEY UNDER

Application No. 31367 Permit No. 24884
IN NAME OF

LAKESIDE WATER DISTRICT


Surveyed Sept. 12 1966. by L. E. Gould

Map of the Lakeside Rural Fire Protection District showing the area in which it is anticipated that the water obtained from Eel Lake will be used, described as follows: Commencing at the Southeast corner of Section 18, Twp. 23 S., Range 12 West of W.M.; thence West to the Southwest corner of Section 13; Twp. 23 S. Range 13 W.M.; thence North to Northwest corner of Section 13; thence East to the Northeast corner of Section 13; thence North to Northwest corner of Lot 14; Section 6, Twp. 23 S., Range 12 W.M. thence East to Northeast corner of Lot 14, Section 6; thence South to the Southeast corner of Lot 2, Section 7; thence East to the center of Section 7; thence South to the Northwest corner of the Southwest Quarter of the Southeast Quarter of Section 7; thence East to the Northeast corner of the Southeast Quarter of the Southeast Quarter of Section 7; thence South to the point of beginning. All being in Twp. 23 South, in Ranges 12 and 13 West of Willamette Meridian, Coos County, Oregon.



TOWNSHIP 23 SOUTH
RANGE 12 & 13 WEST W.M.
COOS COUNTY OREGON

SCALE 1" = 1/4 MILE

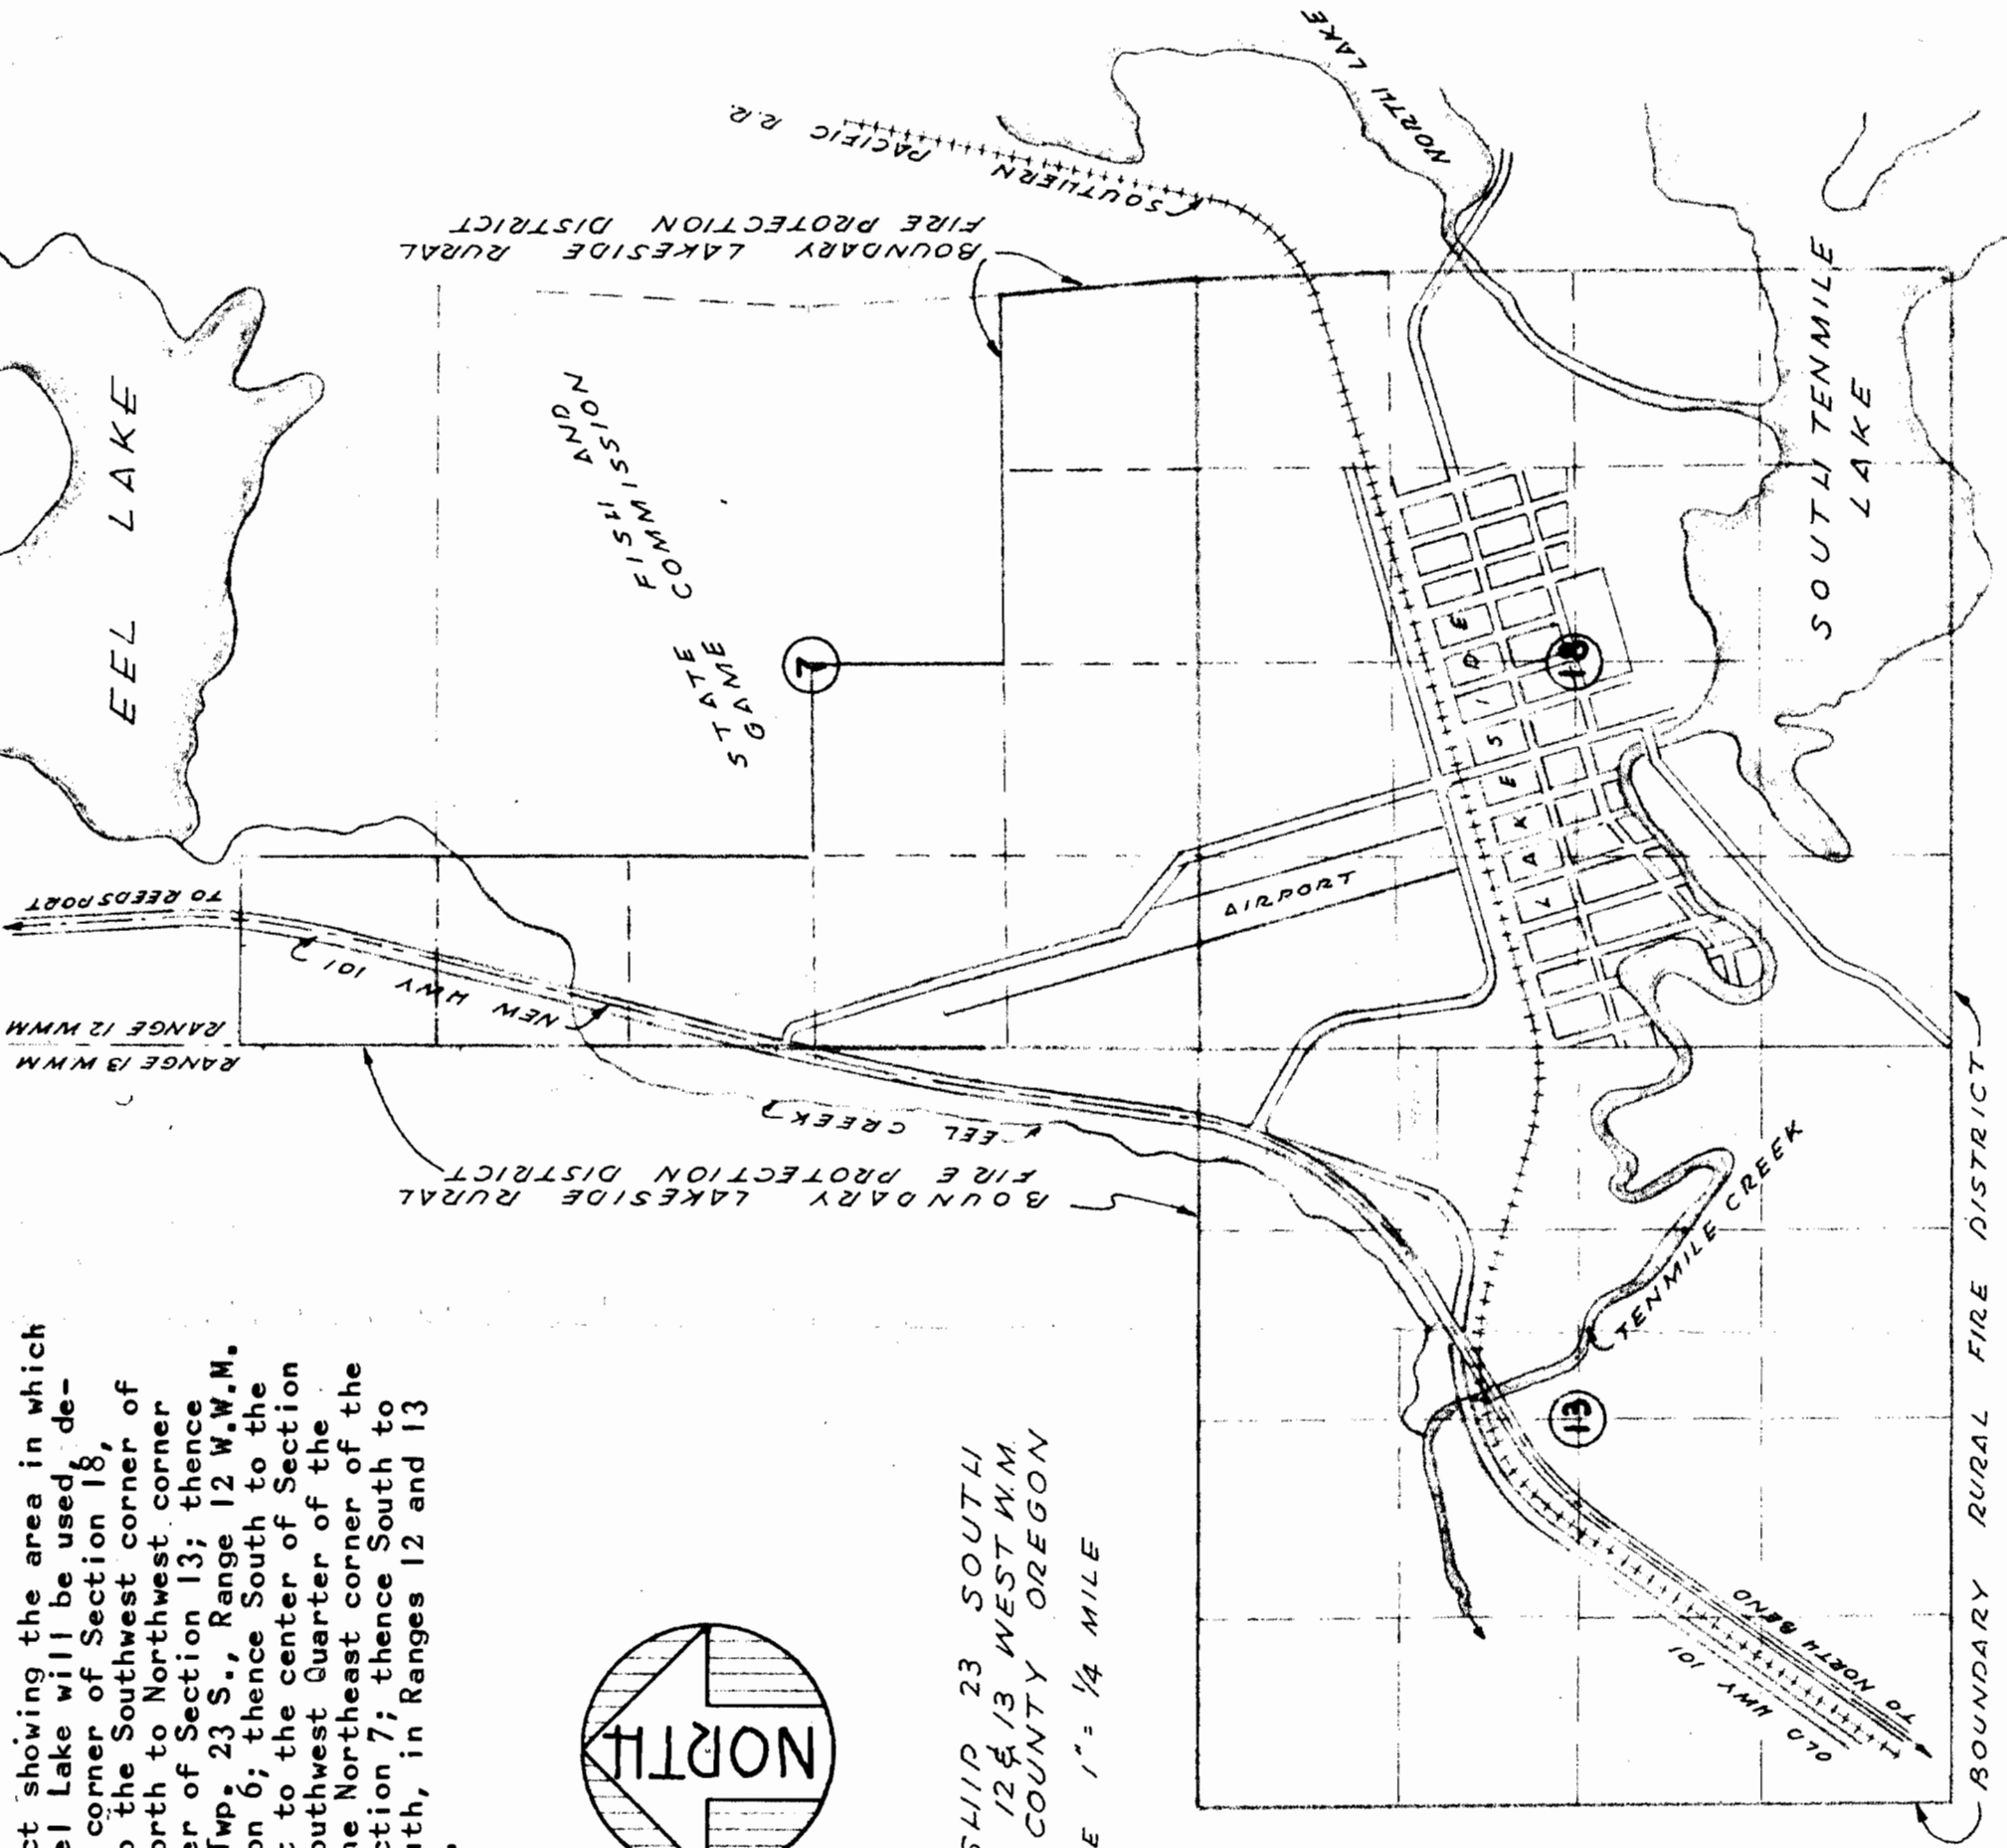

Edward W. Remy

Forward to King

JOA NO 211-B-57.

