# T.25S.R.11W.W.M.

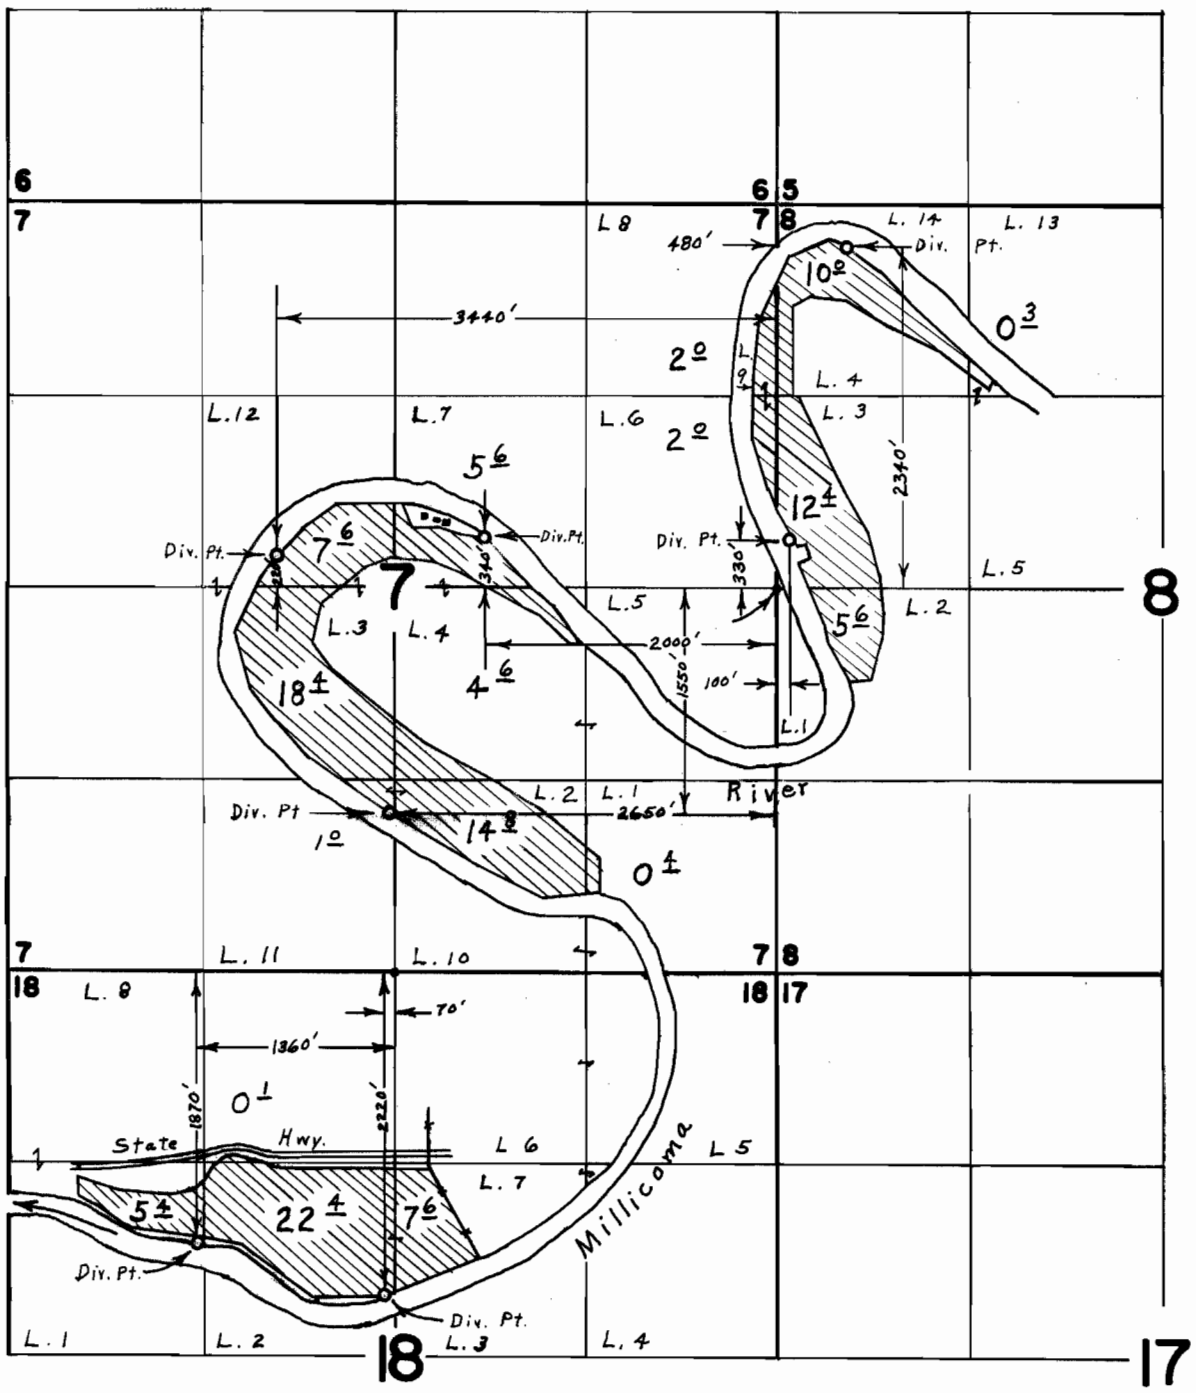


## FINAL PROOF SURVEY
UNDER

Application No. 39845 Permit No. 29662
IN NAME OF

GEORGE W. ROOD

Surveyed Sept. 22 1966, by L. E. Gould

1966 – W