


T.27S.R.5W.W.M.

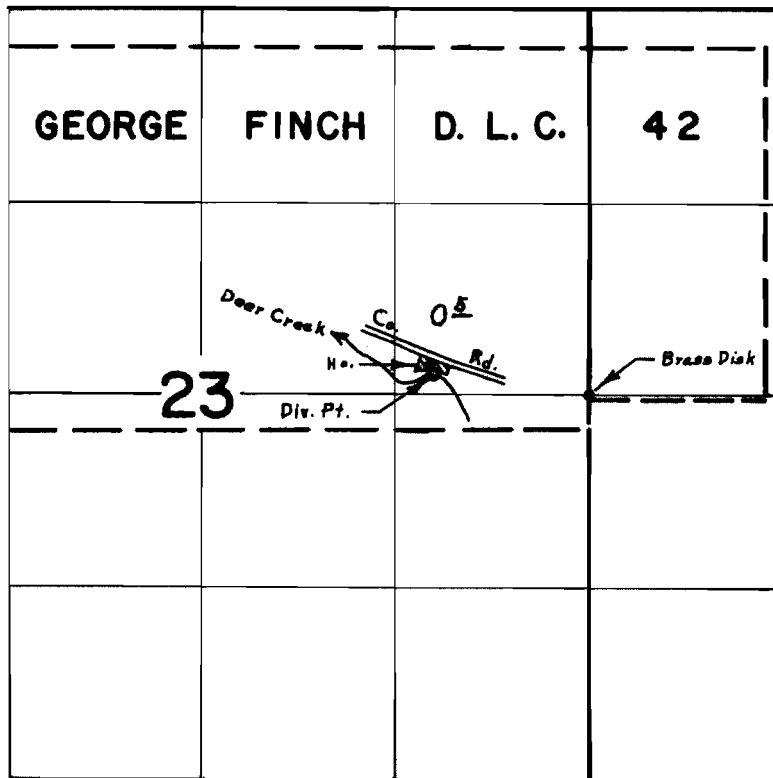

Div. Pt. Located 140' N. & 1060' W. From E. $\frac{1}{4}$ Cor. Sec. 23

FINAL PROOF SURVEY UNDER

Application No. 41409 Permit No. 30734
IN NAME OF

CLIFFORD D. COLLINS

Surveyed May 17, 1966, by L. E. Gould