


# T.27S.R.5W.W.M.

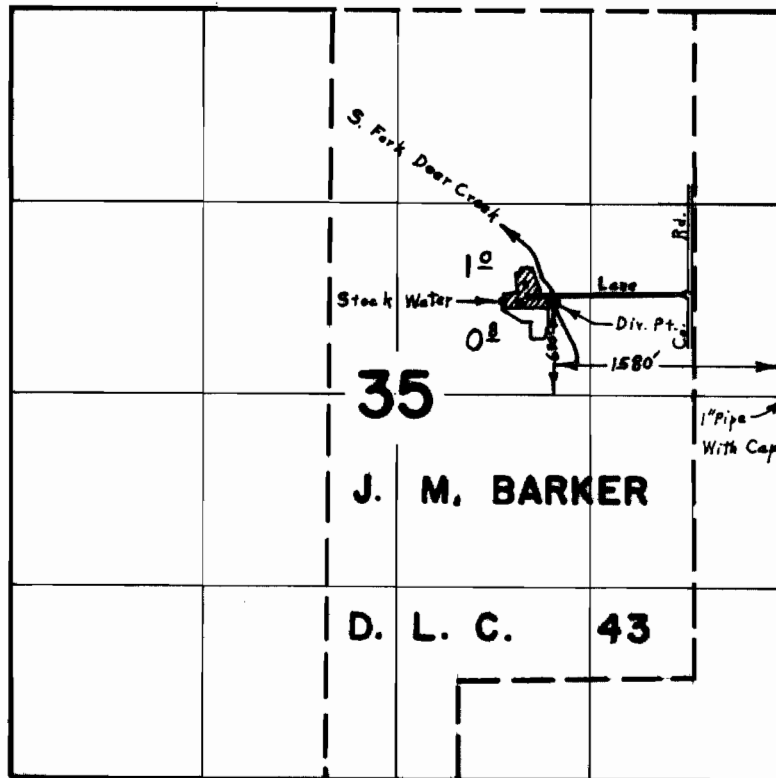

## FINAL PROOF SURVEY UNDER

Application No. 41284 Permit No. 39784  
IN NAME OF  
**CLYDE KESTER**

Surveyed May 18, 1966, by L. E. Geald