


T.27S.R.5W.W.M.

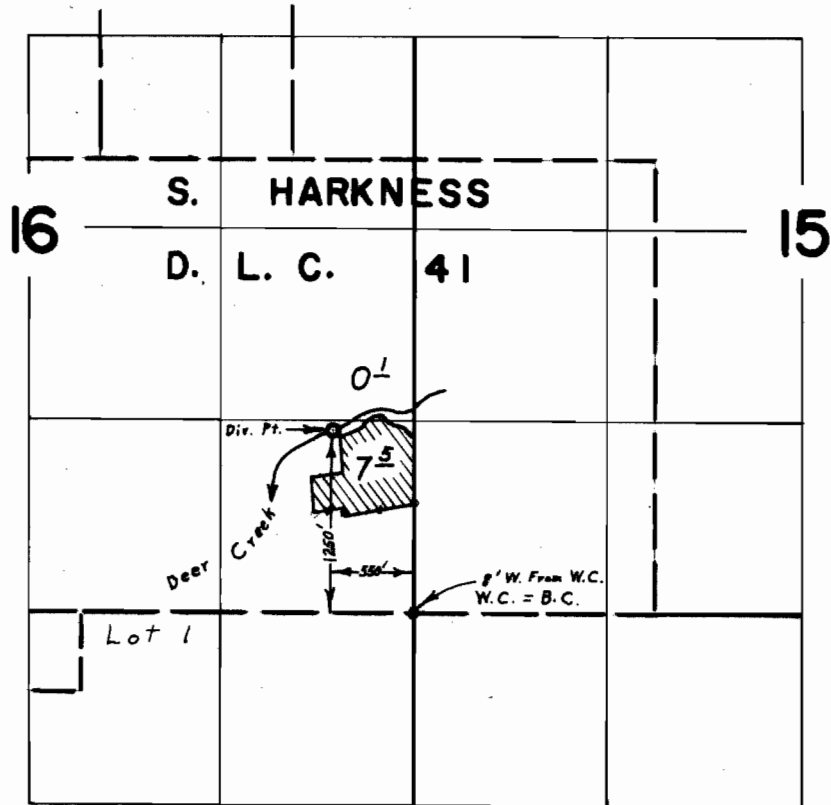

**FINAL PROOF SURVEY**  
UNDER

Application No. 41393 Permit No. 30919  
IN NAME OF

**THOMAS P. STUBBLEFIELD**

Surveyed May 16, 1966, by L. E. Gould