


T.27S.R.5W.W.M.

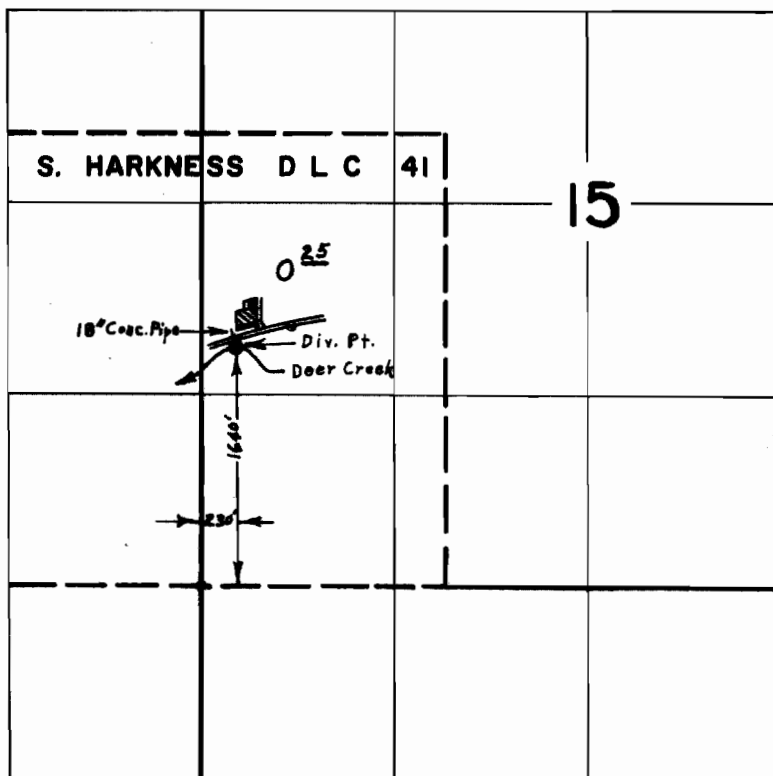

FINAL PROOF SURVEY
UNDER

Application No. 41277 Permit No. 30780
IN NAME OF

WILLIE O. WADDLE

Surveyed May 18, 1966, by L. E. Gould