


T.27S.R.5W.W.M.

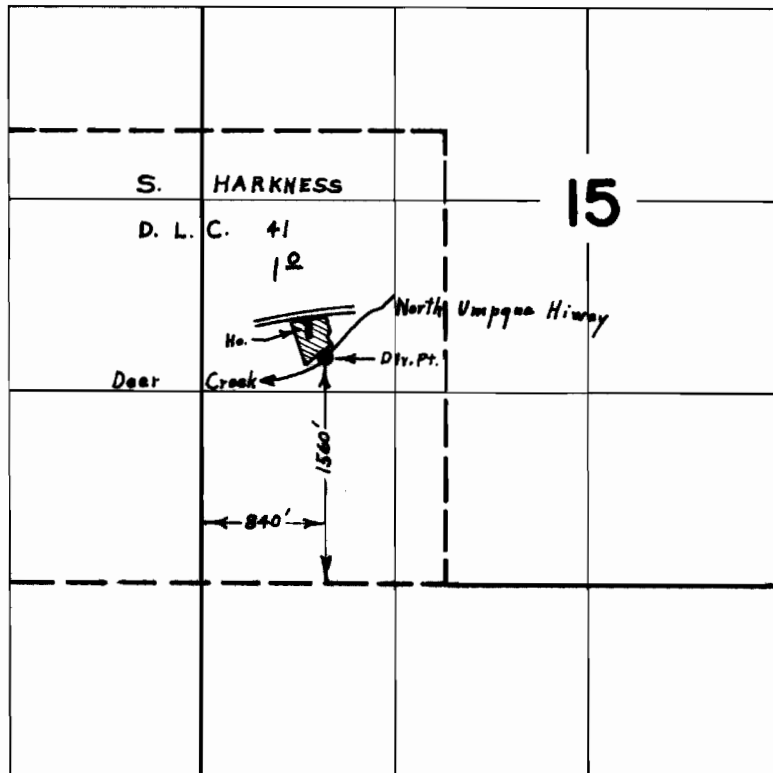

FINAL PROOF SURVEY UNDER

Application No. 41266 Permit No. 30773
IN NAME OF

ALEXANDER & ELEANOR A. MEYER

Surveyed May 17, 1966, by L. E. Gould