


P.28039

34141

T.10S.R.33E.W.M.

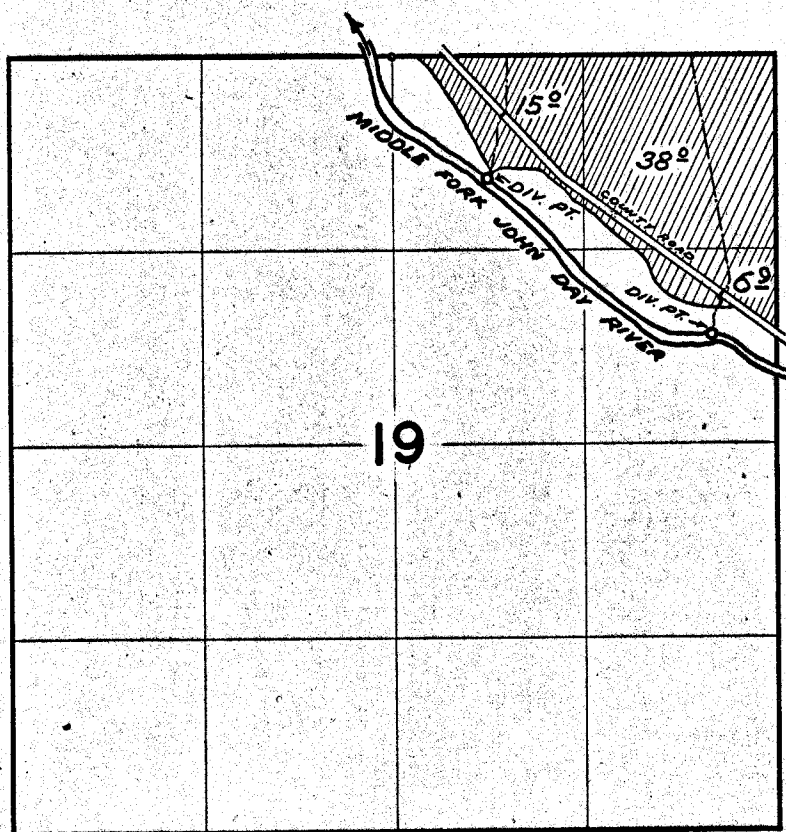

FINAL PROOF SURVEY
UNDER

Application No. 37571 Permit No. 28039
IN NAME OF

STEPHEN C. HOLMES

Surveyed Aug. 6 1965, by G. WARD