


T.36S.R.33E.W.M.

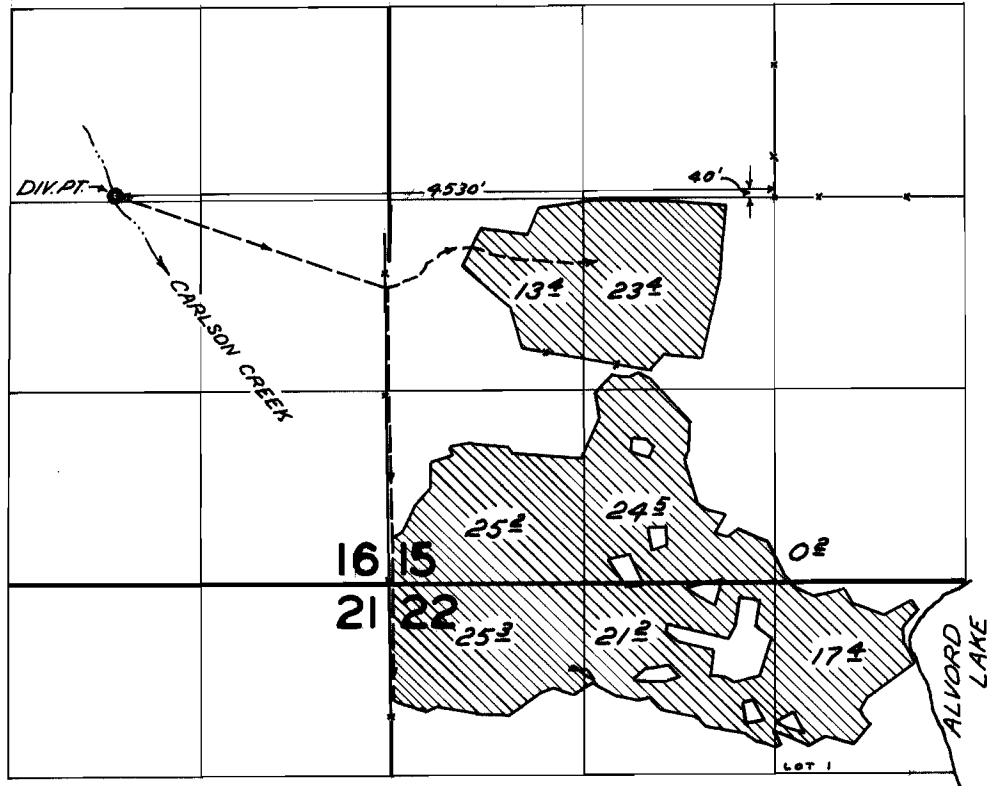

FINAL PROOF SURVEY
UNDER

Application No. 38815 Permit No. 28862
IN NAME OF

ALLIED PROPERTIES

Surveyed OCT. 26 1965, by R. JACKSON