


T.19S.R.33 1/2 & 34 E.W.M.

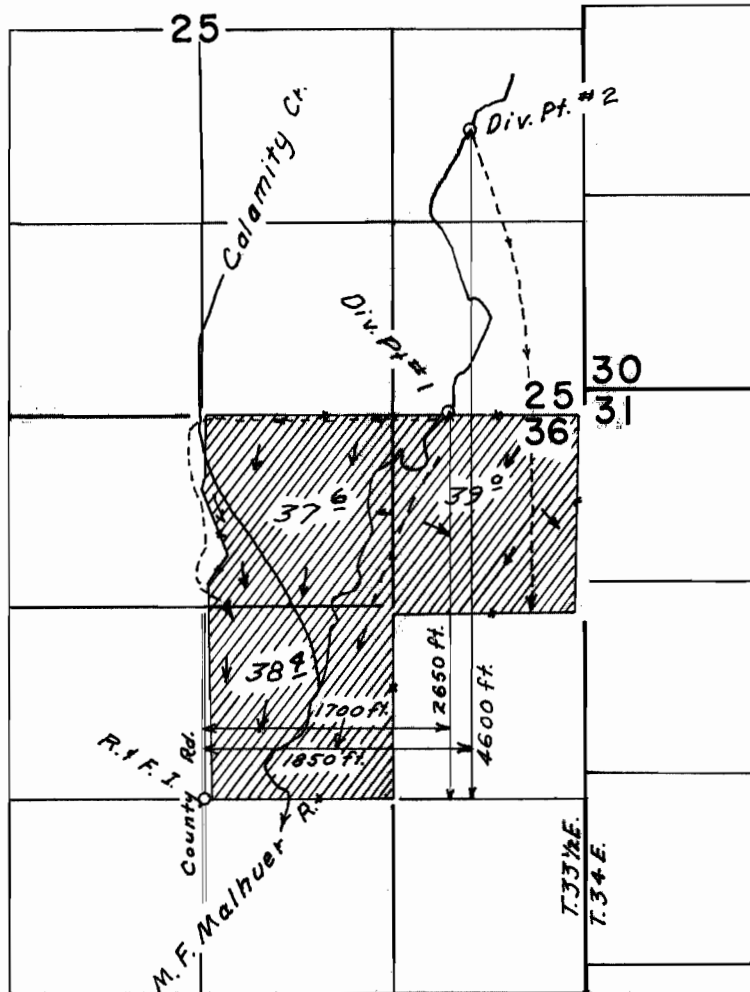

FINAL PROOF SURVEY UNDER

Application No. 34489 Permit No. 27083
IN NAME OF

JOSEF A. LILLARD

Surveyed Sept. 18, 1965, by Clayton Gardner