


T.36S.R.3W.W.M.

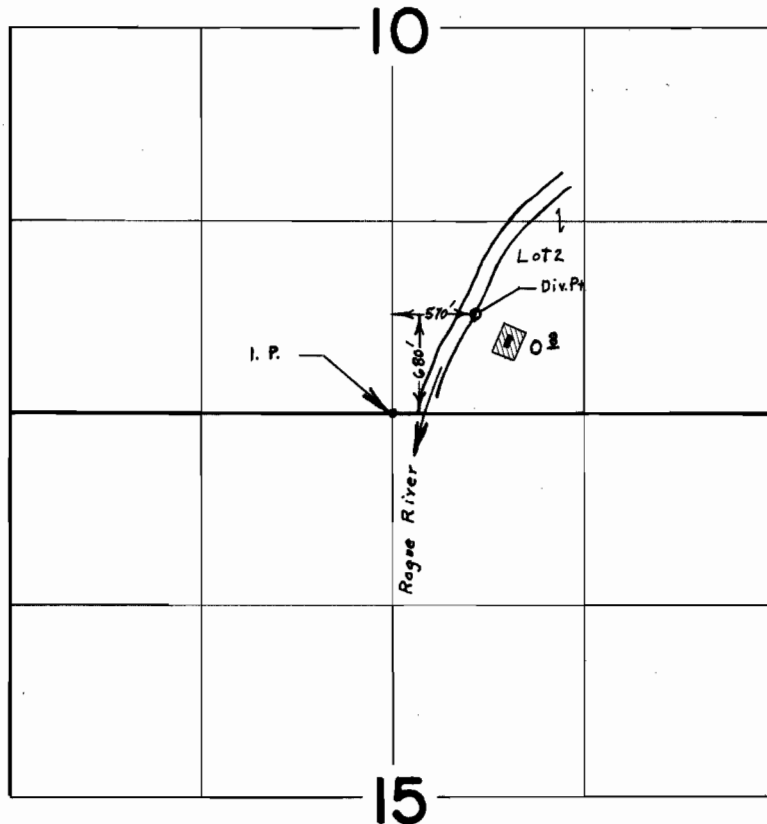

FINAL PROOF SURVEY
UNDER

Application No. 37928 Permit No. 28368...
IN NAME OF

MELVIN L. & DORA E. BURNETT

Surveyed June 6 1966, by R. E. Gould