


T.36S.R.3W.W.M.

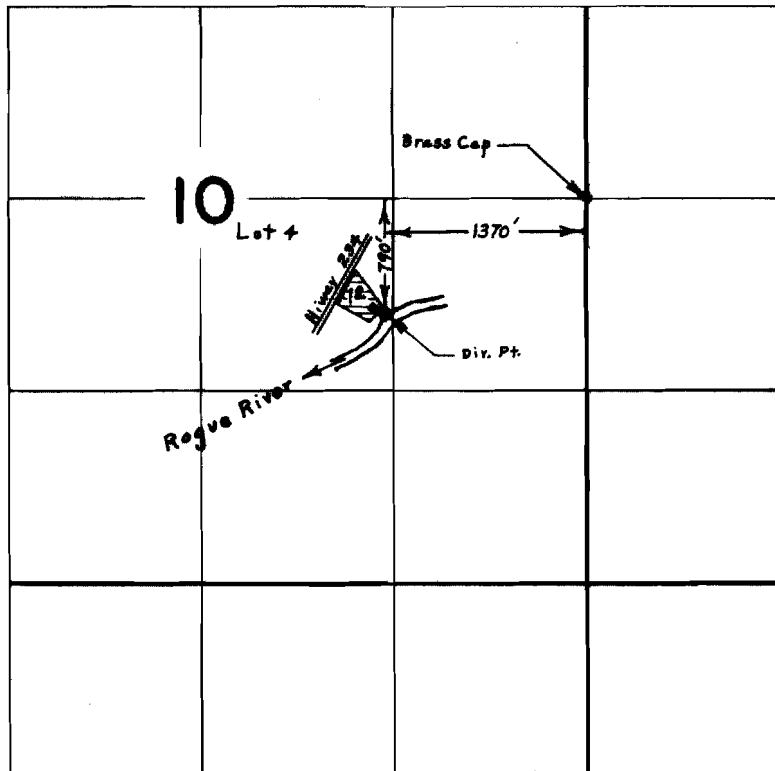

FINAL PROOF SURVEY
UNDER

Application No. 40868 Permit No. 30467
IN NAME OF

EARL COX

Surveyed June 2 1966, by L. E. Gould