


# T.36S.R.4W.W.M.

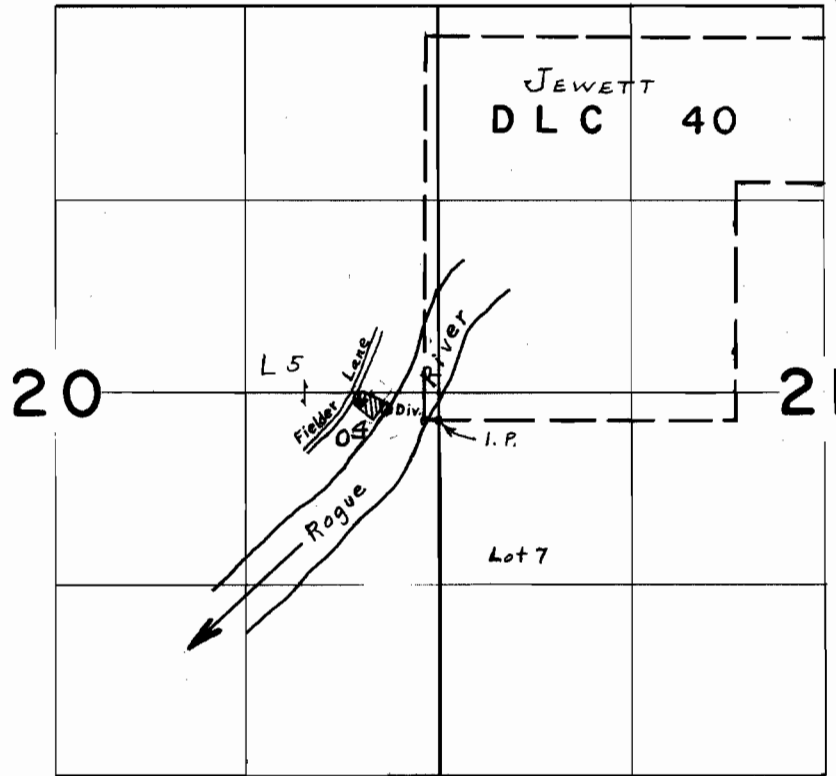

Div. Pt. Located 260' W. & 60' N. From N.W. Cor. Lot 7 (NW 1/4 SW 1/4)  
Section 21

## FINAL PROOF SURVEY UNDER

Application No. 39913 Permit No. 29708  
IN NAME OF

MEREDITH G. LUSE

Surveyed June 8 1966, by L. E. Gould