


T.32S.R.3E.W.M.

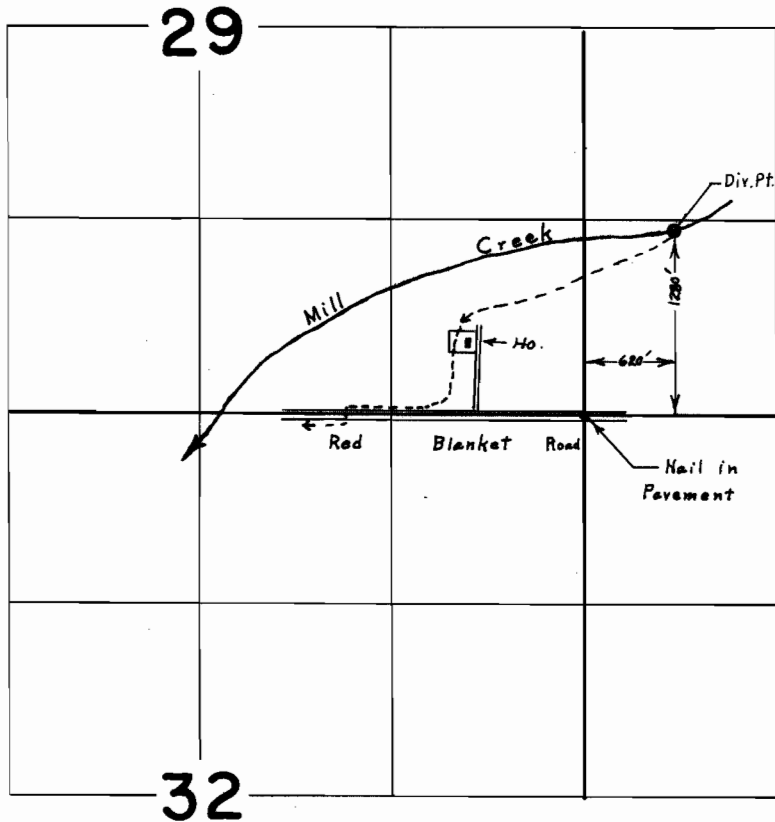

**FINAL PROOF SURVEY**  
UNDER

Application No. 38550 Permit No. 28682  
IN NAME OF

B. B. MAKINSON

Surveyed July 21, 1966, by L. E. Gould