


T.33S.R.2E.W.M.

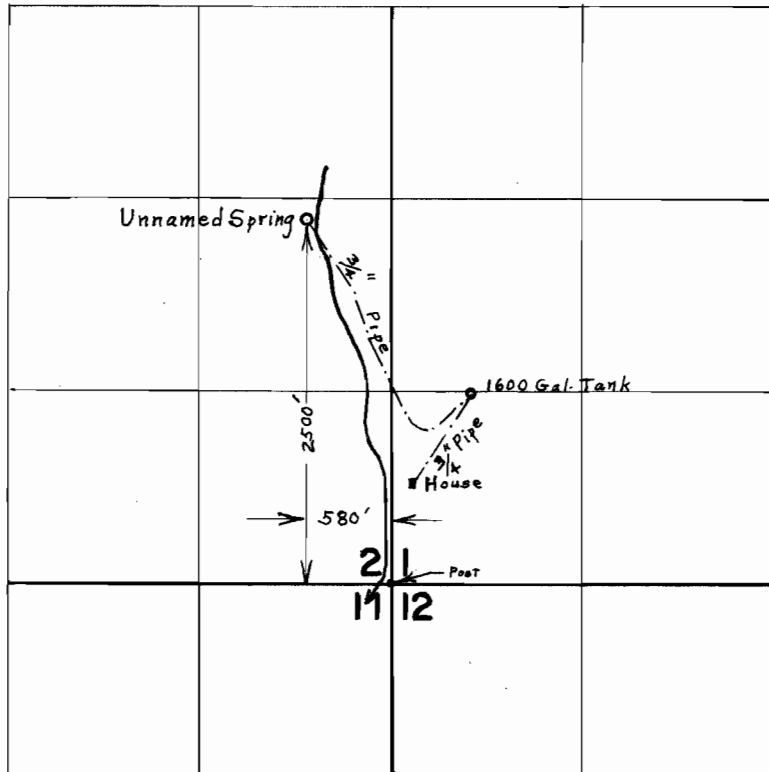

FINAL PROOF SURVEY UNDER

Application No. 39195 Permit No. 29224
IN NAME OF

MARY M. AND OR SHERMAN D. POOLE

Surveyed July 22 1966, by L. E. Gould