


T.36S.R.3W.W.M.

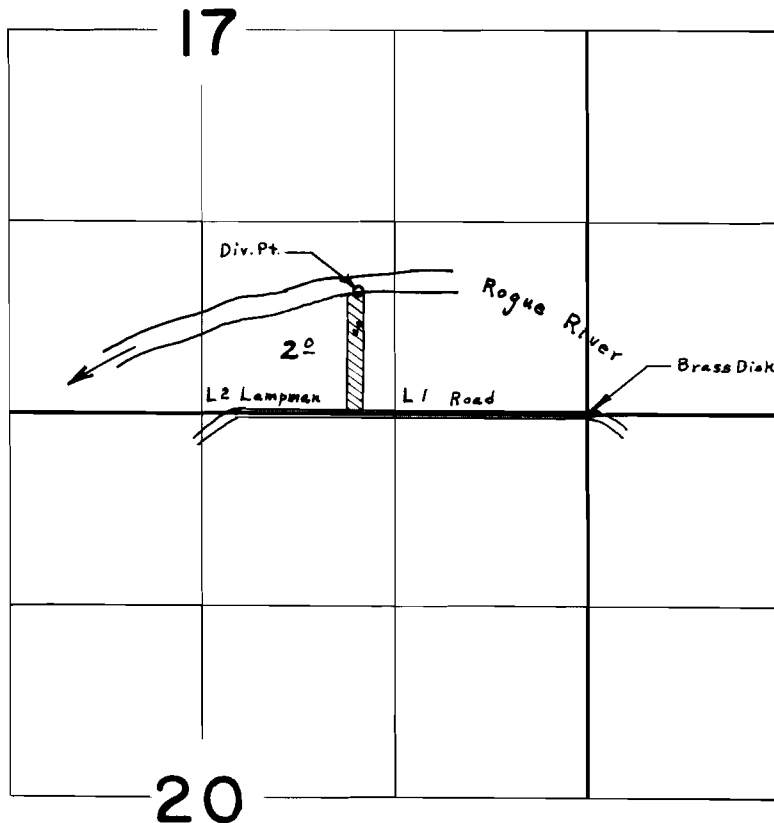

Div. Pt. Located 1560' W. & 850' N. From S.E. Corner Section 17

FINAL PROOF SURVEY
UNDER

Application No. 35602 Permit No. 27629
IN NAME OF

EARL E. AND RUTH E. ROHLF

Surveyed June 3, 1966, by L. E. Gould