


T.34S.R.1W.W.M.

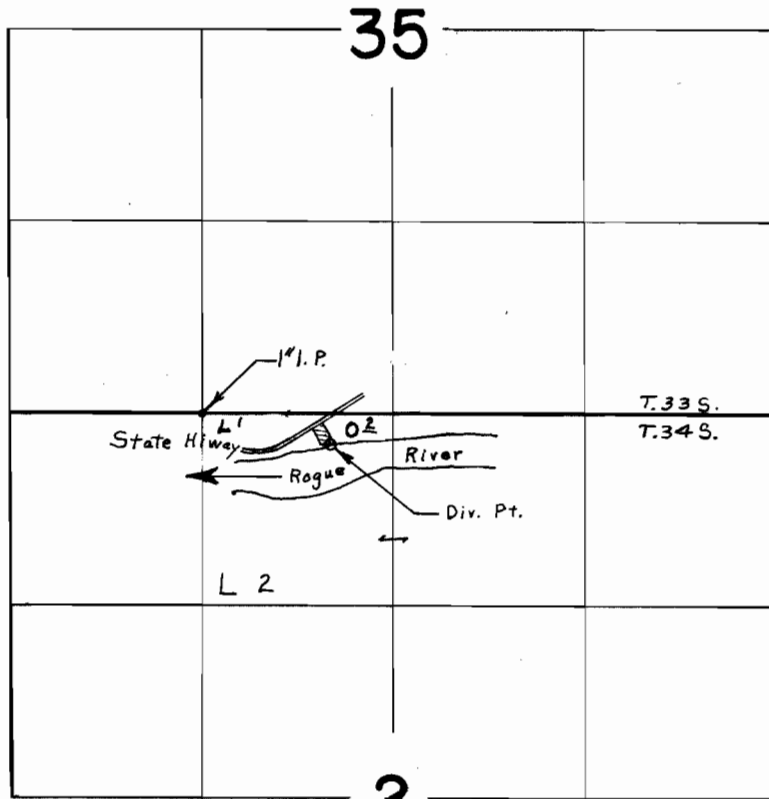

Div. Pt. Located 880' E. & 210' S. N.W. Cor. N.E. $\frac{1}{4}$, N.W. $\frac{1}{4}$, Sec. 2

FINAL PROOF SURVEY
UNDER

Application No. 39130 Permit No. 29123
IN NAME OF

ELIZABETH T. WILSON

Surveyed July 14, 1966, by L. E. Gould