



T. 39 S. R. 5 W.W.M.

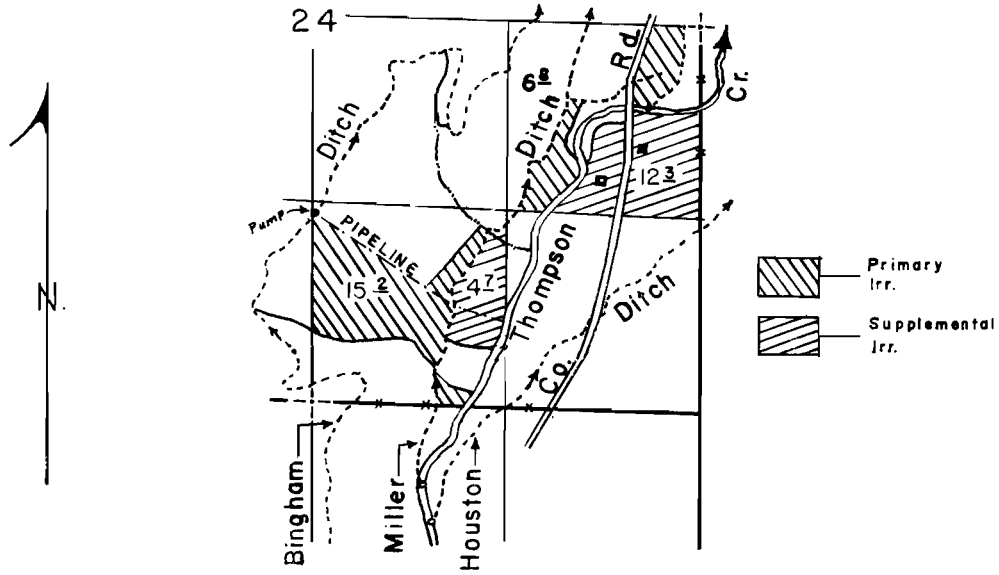

T. 40 S. R. 5 W.W.M.

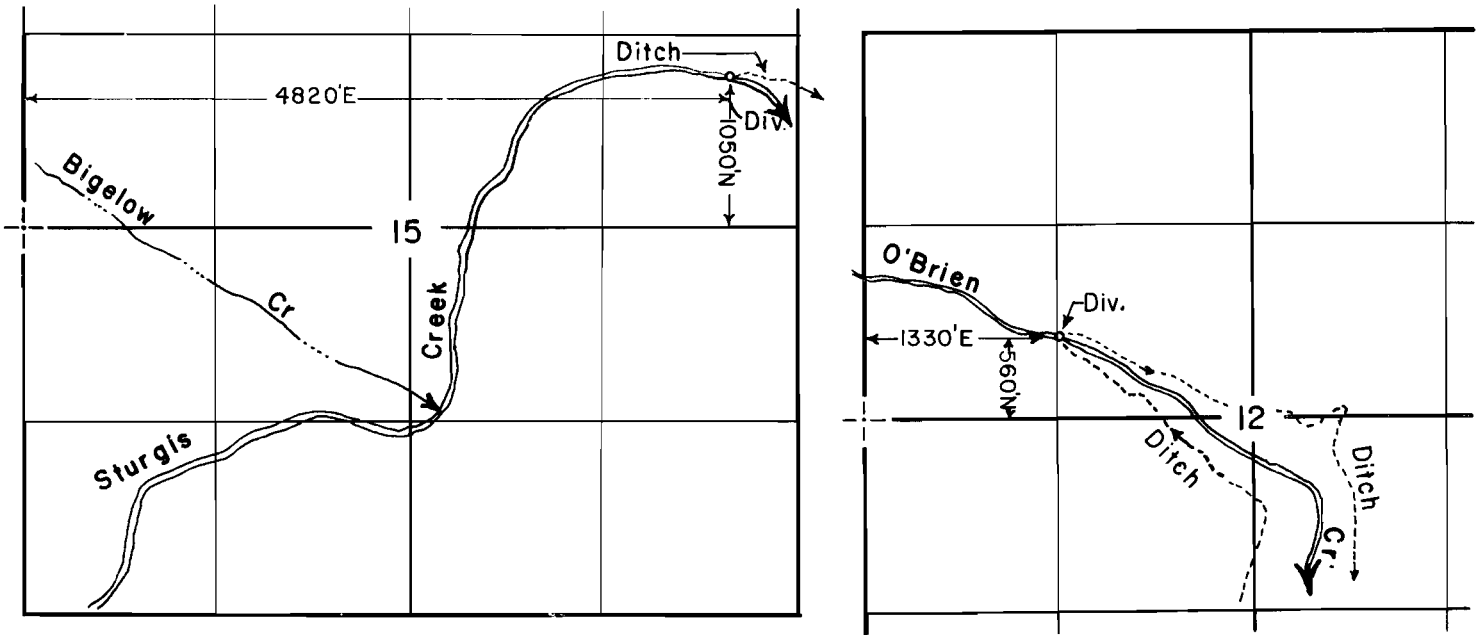

FINAL PROOF SURVEY UNDER

Application No. 17798 Permit No. 13477
IN NAME OF

Florence Bross

Surveyed Jan 19 1967, by D.C. Hendrix