


T.37S.R.9W.W.M.

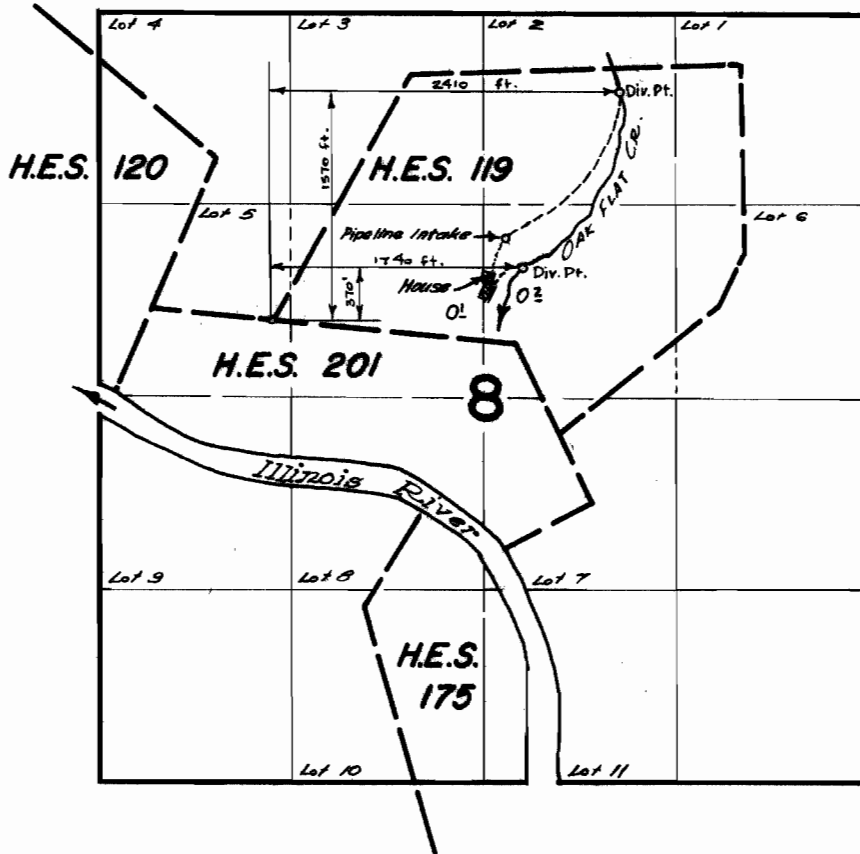

FINAL PROOF SURVEY
UNDER

Application No. **37423**... Permit No. **27869**...
IN NAME OF

JAMES & MYRTLE BUCKLIN

Surveyed *July 15, 1965*, by *A. Jackson*