


T.36S.R.5W.W.M.

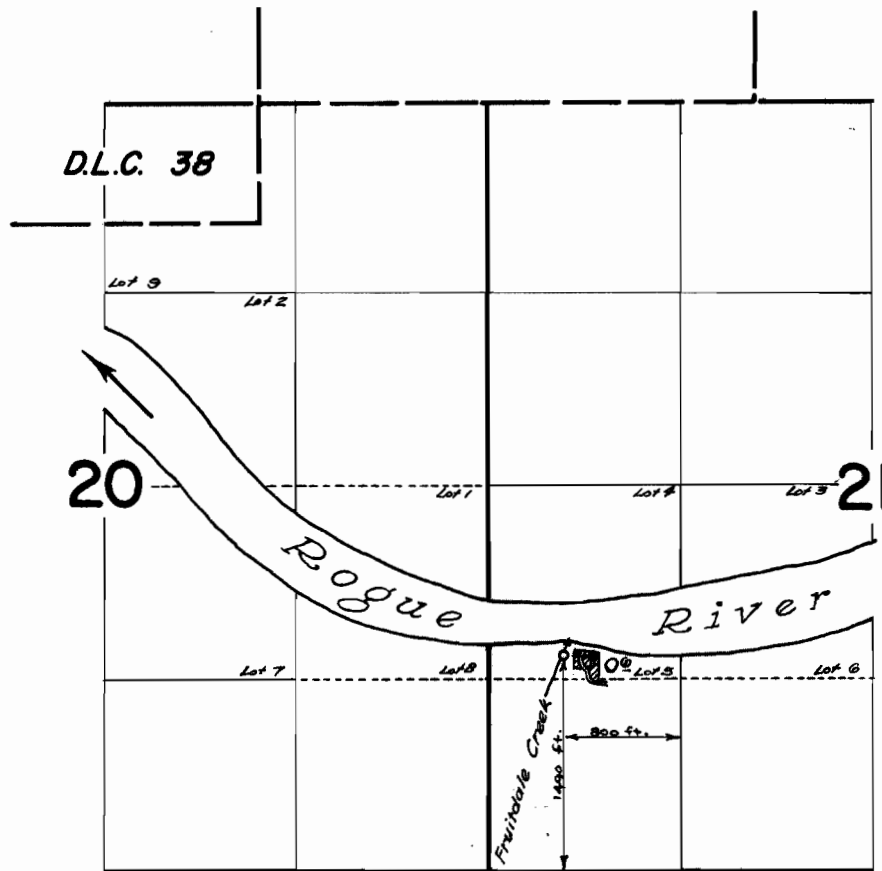

FINAL PROOF SURVEY
UNDER

Application No. 38784... Permit No. 28882...
IN NAME OF

NAN B. CARNAHAN

Surveyed June 30, 1965, by *R. Jackson*