


T.36S.R.6W.W.M.

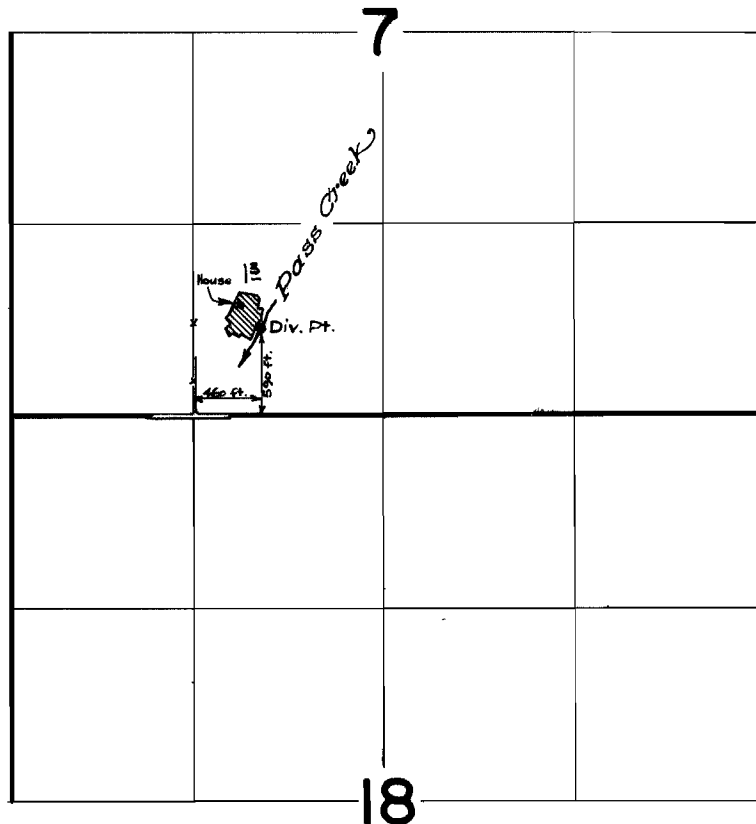

FINAL PROOF SURVEY
UNDER

Application No. 37215 Permit No. 27732
IN NAME OF

ROBERT CORNETT

Surveyed June 28 1965, by R. Jackson