


T.36S.R.5W.W.M.

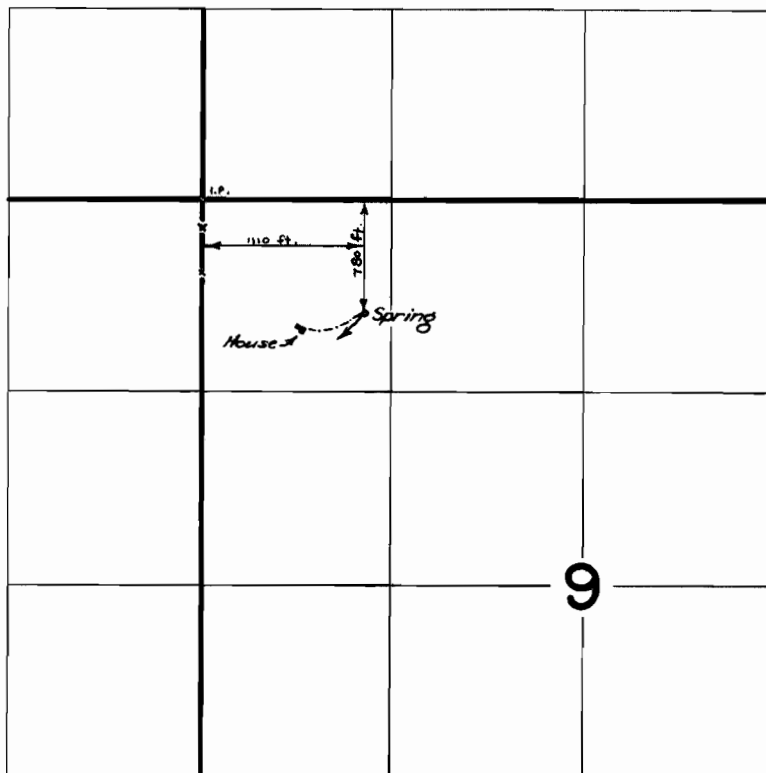

FINAL PROOF SURVEY
UNDER

Application No. 38971 Permit No. 29037
IN NAME OF

DON THOMAS DURBORAW

Surveyed July 2 1965, by R. Jackson