

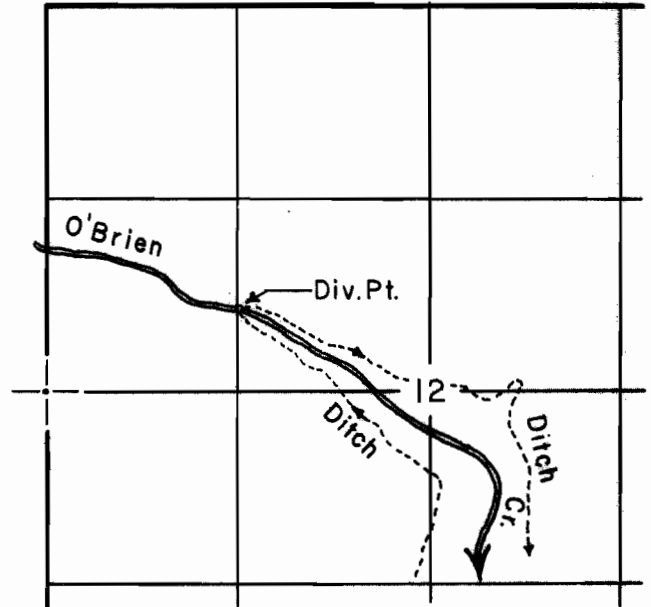


T. 40 S. R. 5. W. W. M.

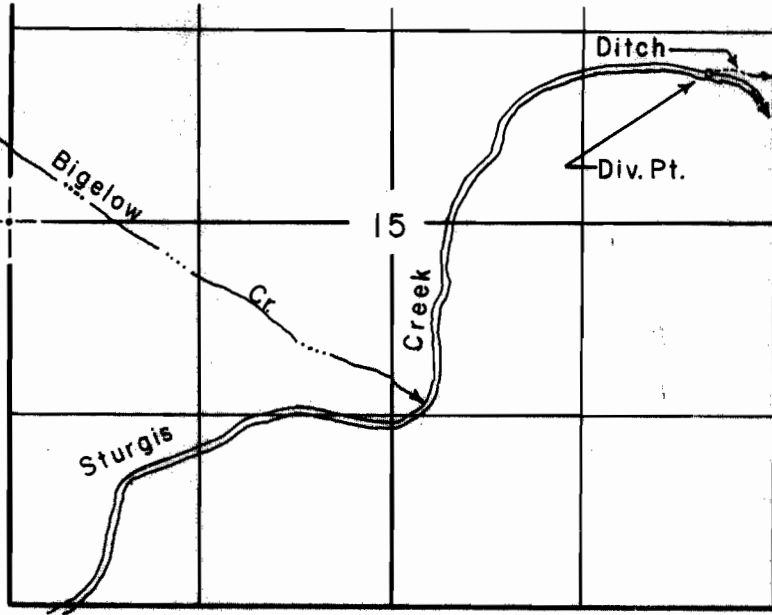

T. 38 S. R. 4. W. W. M.

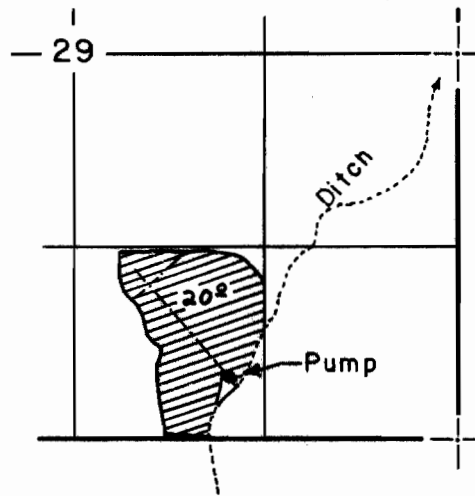

FINAL PROOF SURVEY
UNDER

Application No. 34127 Permit No. 26895
IN NAME OF

C.H. Elmore

Surveyed June 14, 1963, by D.C. Hendrix