


Per. 28643

26-5-20

# T.36S.R.5W.W.M.

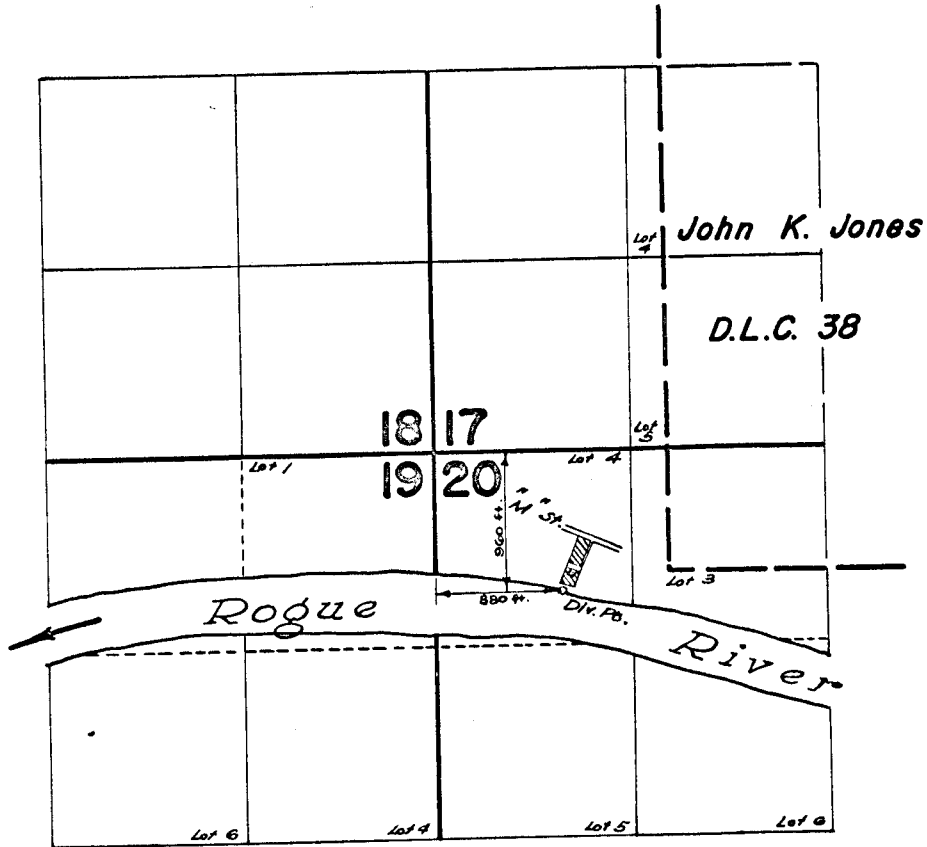

## FINAL PROOF SURVEY UNDER

Application No. 38463... Permit No. 28643...  
IN NAME OF

HENRY C. EMBREY

Surveyed July 20, 1965, by *R. Peterson*

Not survey