


T.35S.R.8W.W.M.

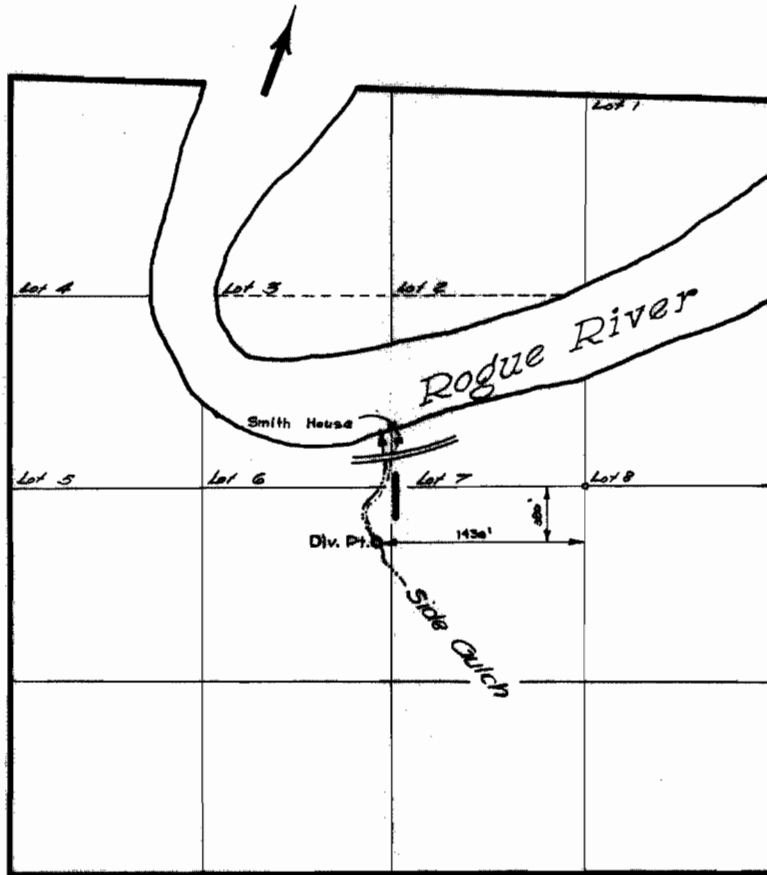

FINAL PROOF SURVEY
UNDER

Application No. 34452... Permit No. 27066...

IN NAME OF

JOE & MILDRED E. KUCERA

SHERMAN S. & MARY L. SMITH

Surveyed July 13, 1965, by *[Signature]*