


T.34S.R.6W.W.M.

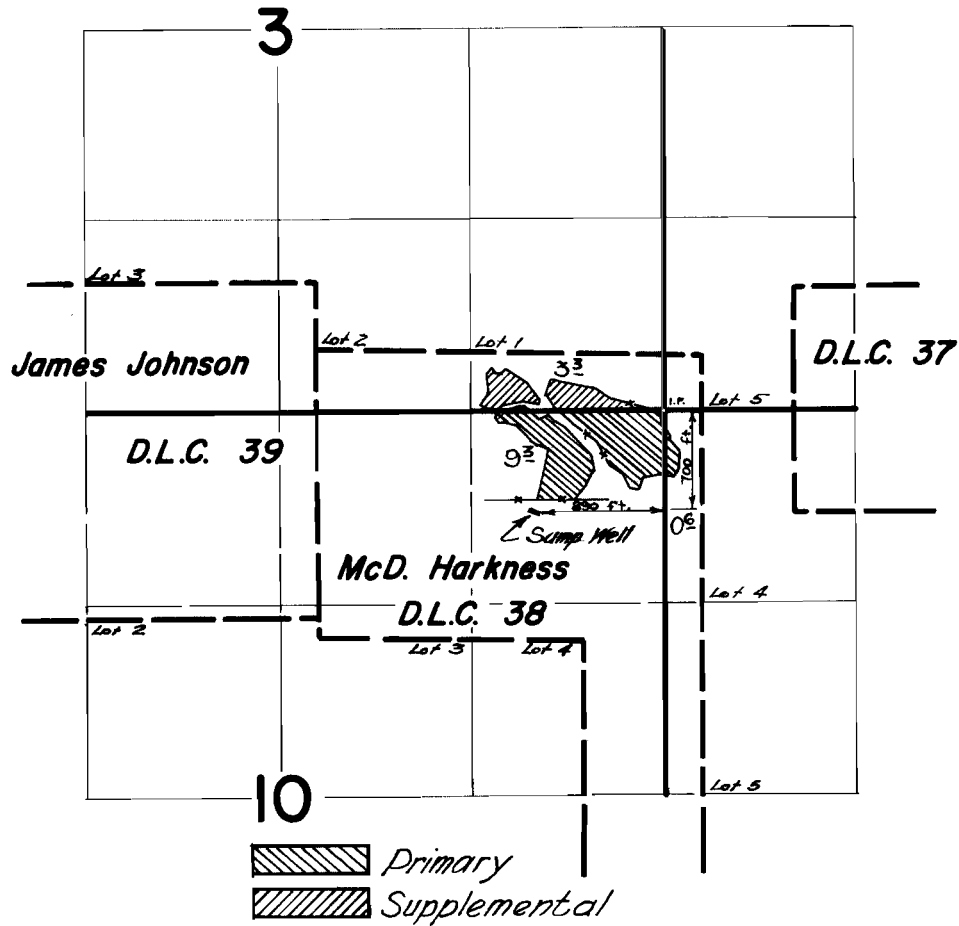

FINAL PROOF SURVEY UNDER

Application No. G-1950.. Permit No. G-1792..
IN NAME OF

J. W. & LILLIE C. MURPHY

Surveyed July 14, 1965, by *R. Jackson*