


U-700  
34168

# T.38S. R.11 1/2 E.W.M.

Buck Crk. : Yuma Valley wells

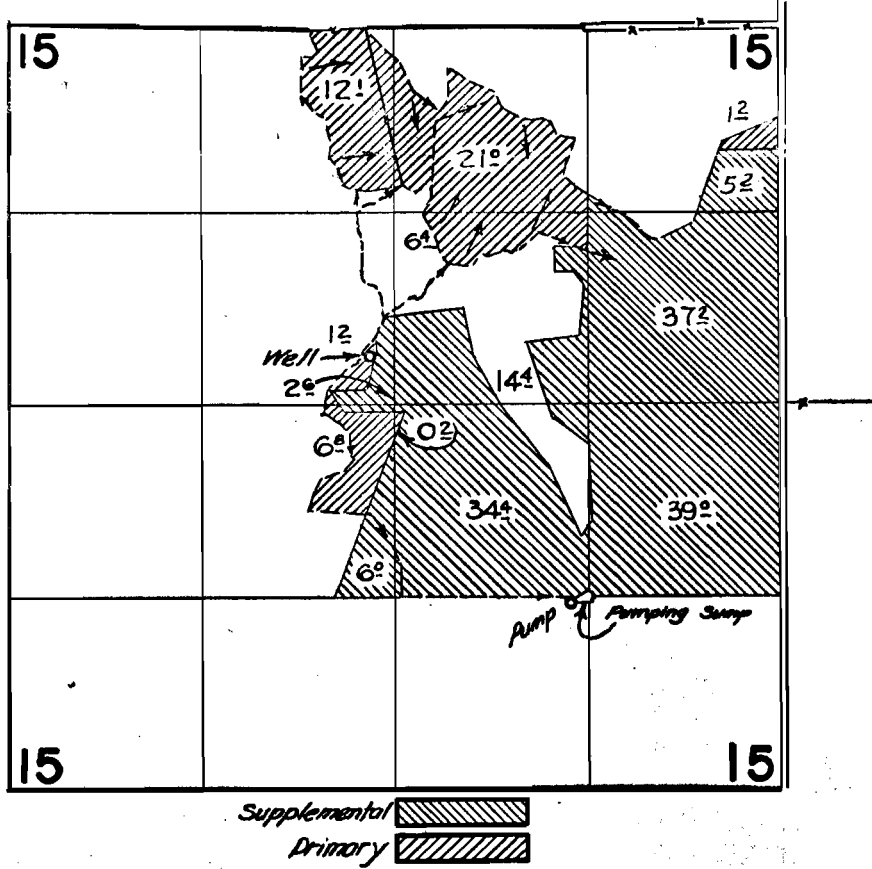

## FINAL PROOF SURVEY UNDER

Application No. U-448. Permit No. U-700.  
IN NAME OF

Marvin E. Graham

Surveyed May 25, 1964, by [Signature]