


2500

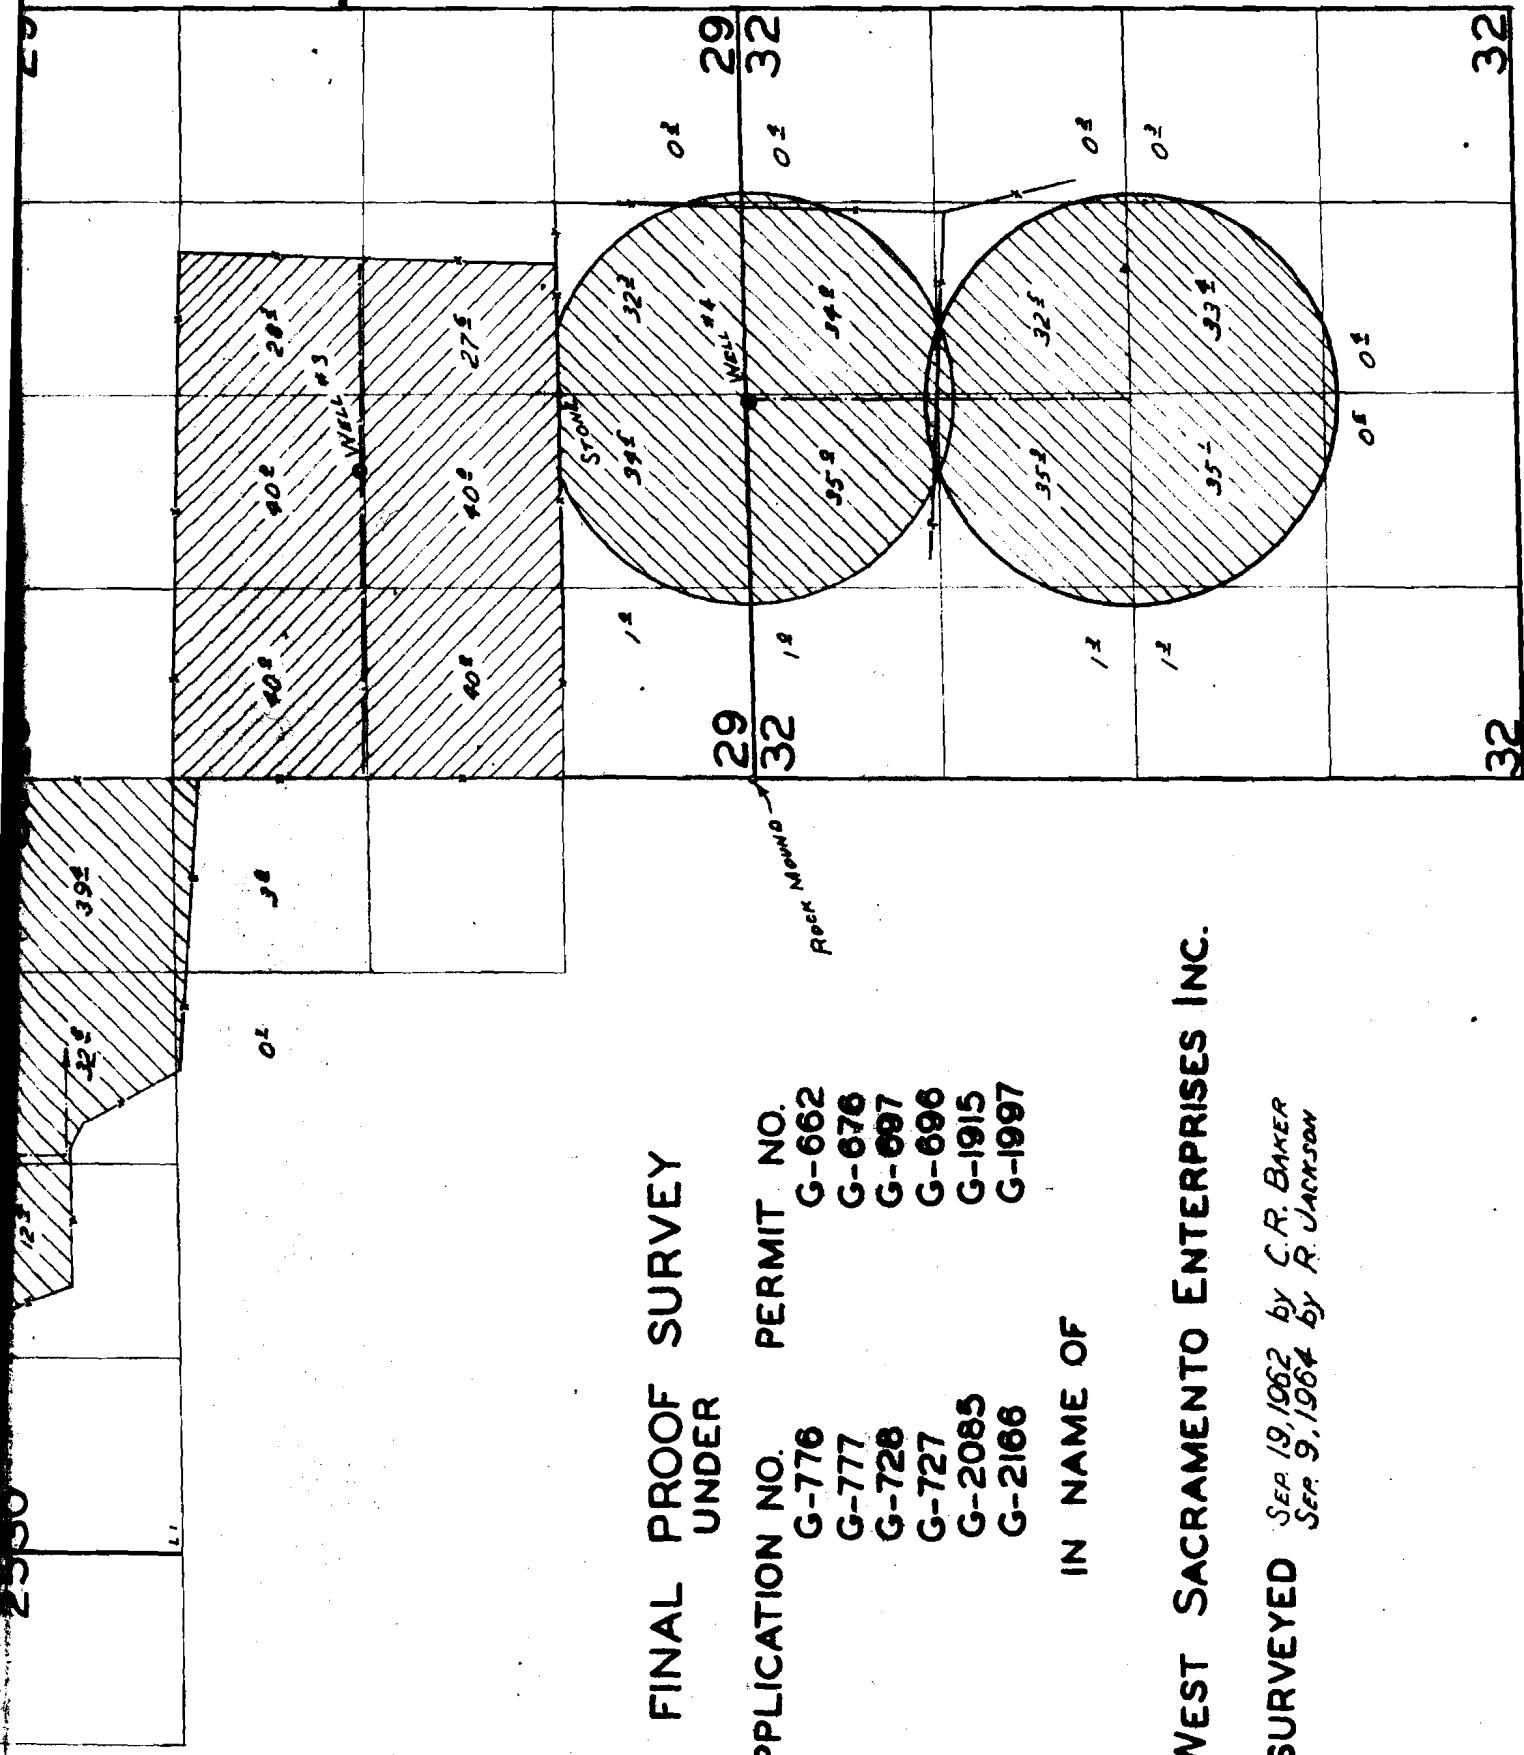

**FINAL PROOF SURVEY
UNDER**

- | APPLICATION NO. | PERMIT NO. |
|-----------------|------------|
| G-776 | G-662 |
| G-777 | G-676 |
| G-728 | G-697 |
| G-727 | G-696 |
| G-2085 | G-1915 |
| G-2166 | G-1997 |

IN NAME OF

WEST SACRAMENTO ENTERPRISES INC.

SURVEYED SEP 19, 1962 by C.R. BAKER
SEP 9, 1964 by R. JACKSON