


T.27S.R.18&19E.W.M.

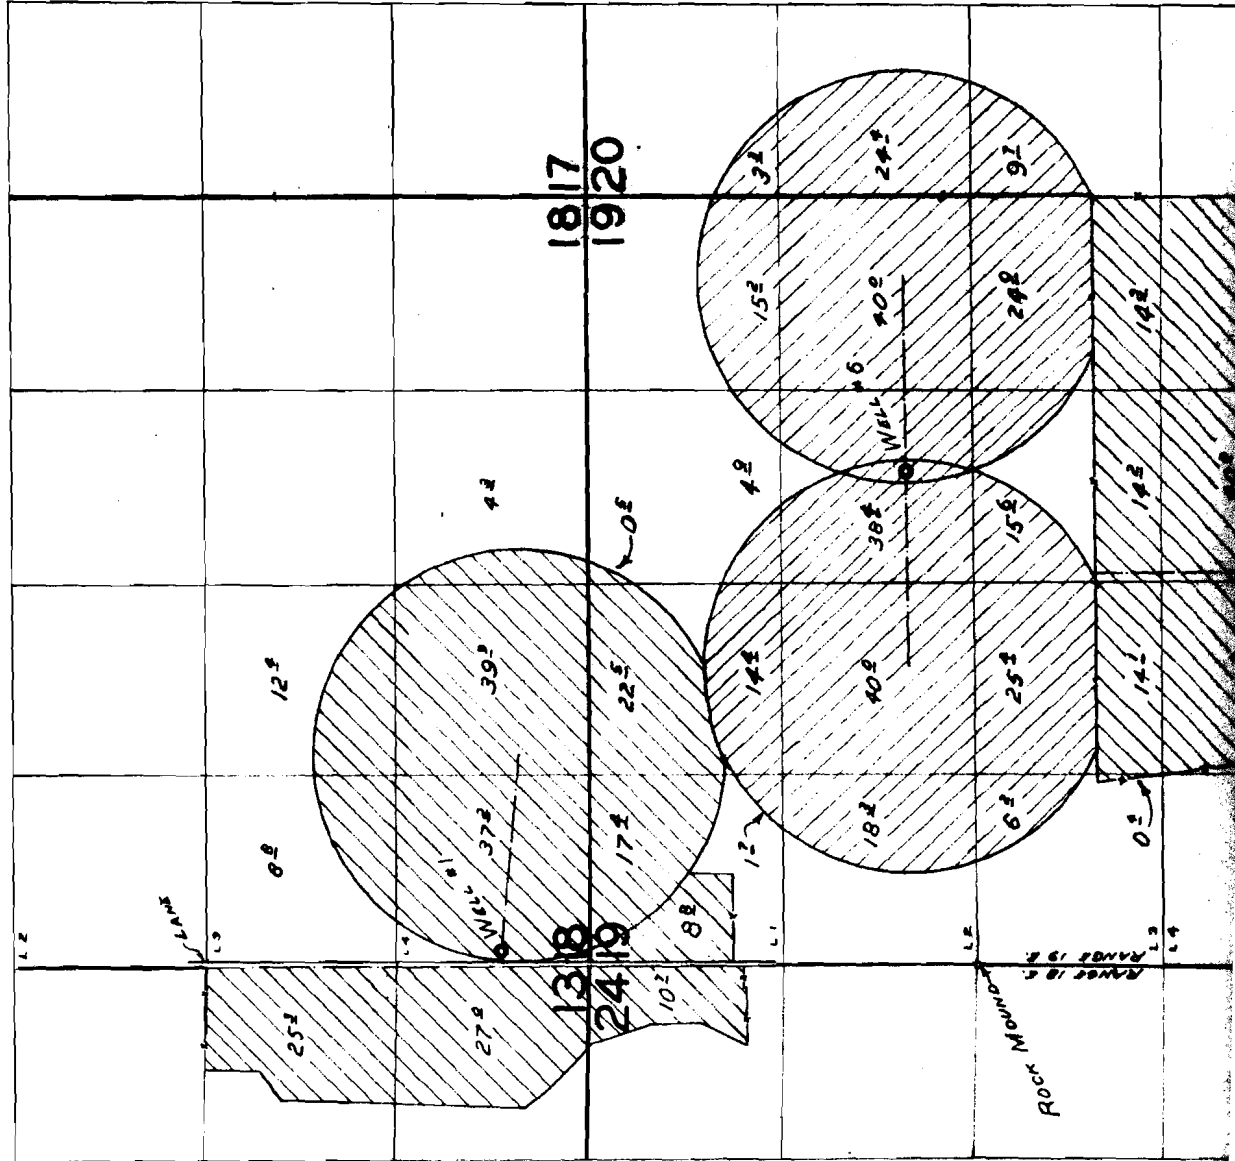

FINAL PROOF SURVEY
UNDER

APPLICATION NO.

PERMIT NO.

G-776

G-662

G-777

G-676

G-728

G-697

G-727

G-696

G-2085

G-1915

G-2166

G-1997

IN NAME OF

WEST SACRAMENTO ENTERPRISES INC.

SURVEYED *SEP. 19, 1962* by *C.R. BAKER*
SEP. 9, 1964 by *R. JACKSON*

