


T. 16 & 17 S. R. 2 E. W. M.

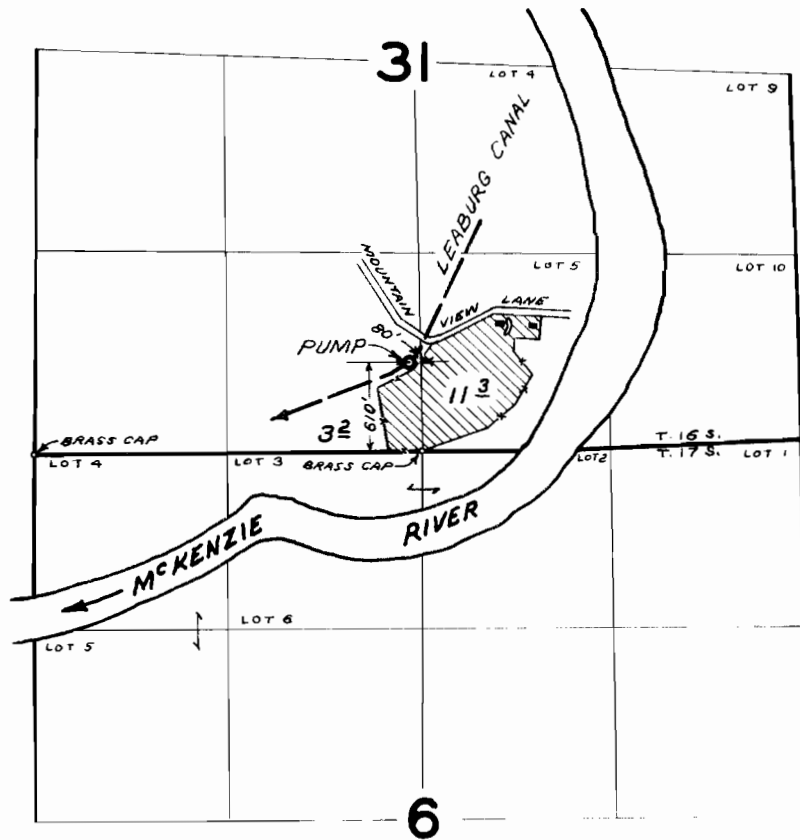

FINAL PROOF SURVEY
UNDER

Application No. 37739 Permit No. 28097
IN NAME OF

RAYMOND E. CHANCE

Surveyed AUG. 30, 1966, by L. Gould