


T.16S.R.2E.W.M.

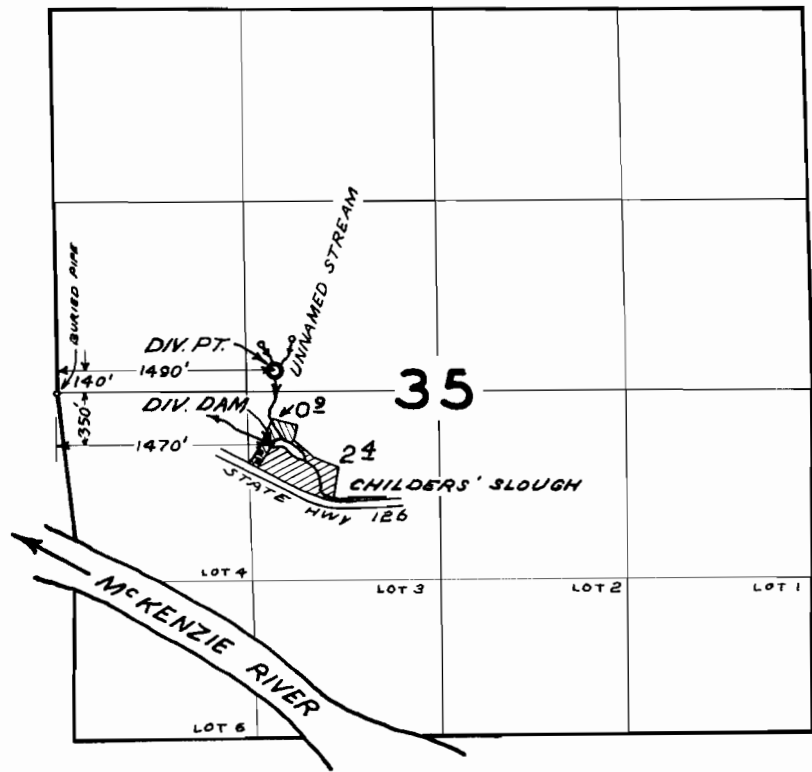

FINAL PROOF SURVEY
UNDER

Application No. 35659 Permit No. 27549
IN NAME OF

ARTHUR A. CHILDERS

Surveyed SEP 2 1966, by L. GOULD