


T.20&21 S. R.3 W.W.M

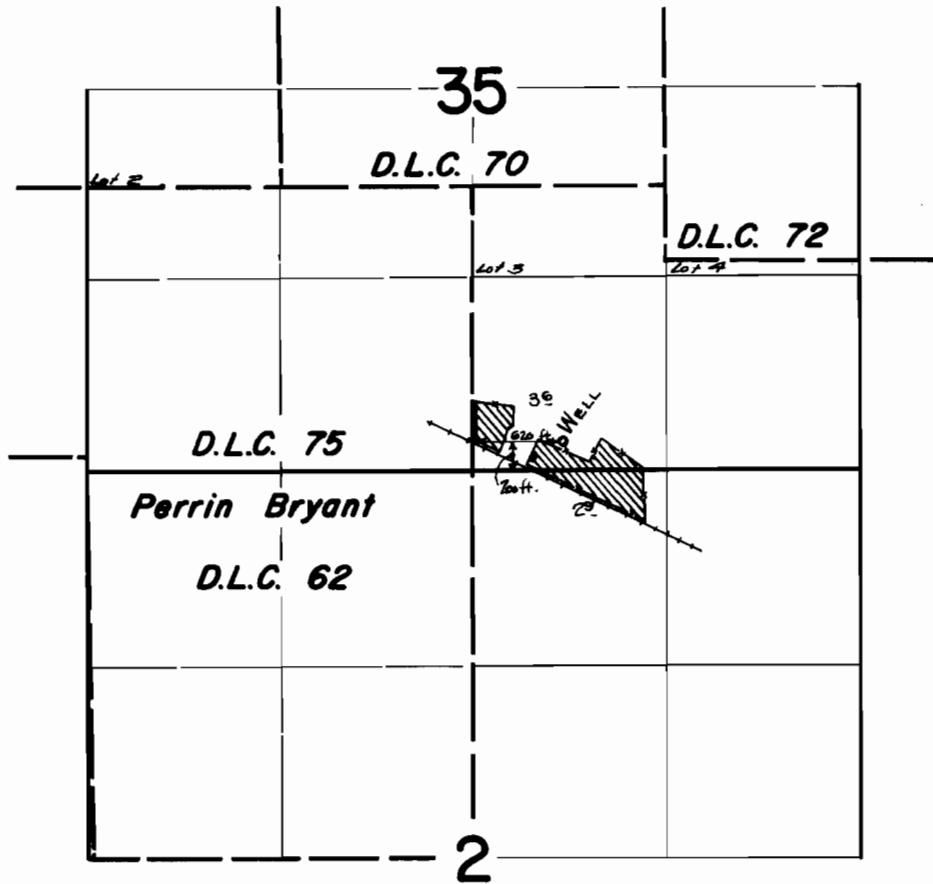

FINAL PROOF SURVEY UNDER

Application No. G-1795 Permit No. G-1672
IN NAME OF

ALVIN J. KIEF

Surveyed April 28 1965, by *A. Jackson*