


T.19 S. R.3 W. W.M.

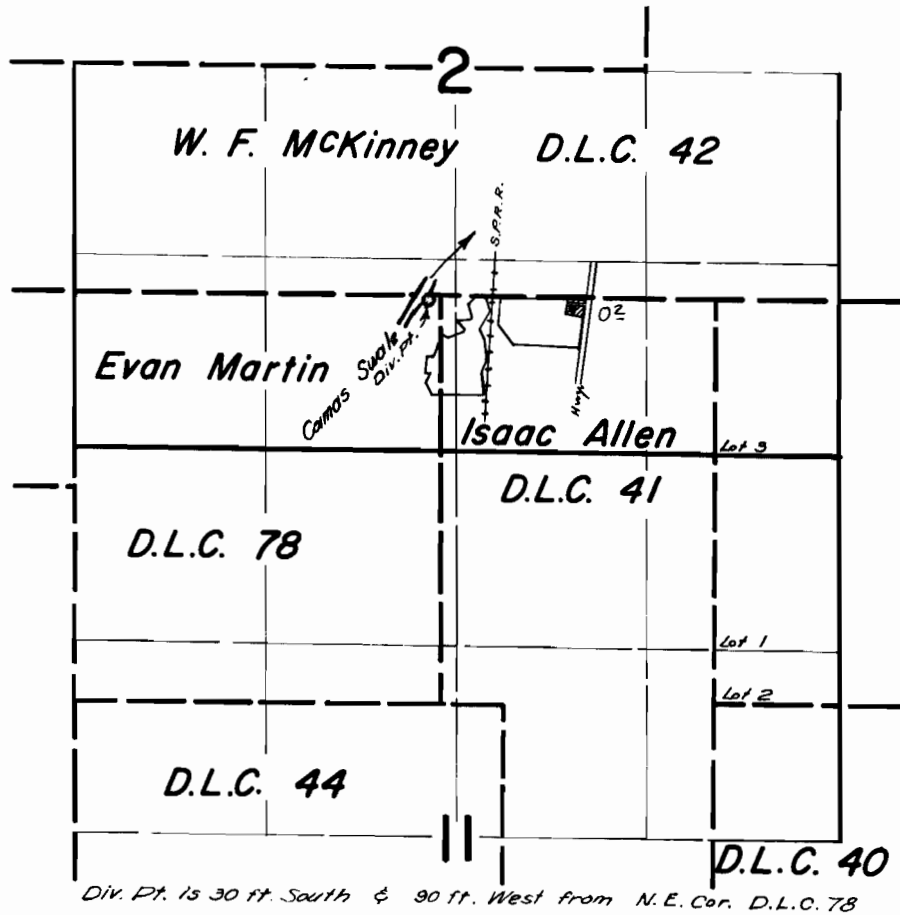

FINAL PROOF SURVEY
UNDER

Application No. 32360 ... Permit No. 25532 ...
IN NAME OF

WILLIAM C. LAND

Surveyed April 29, 1965, by *R. Jackson*