


T.17S.R.1E.W.M.

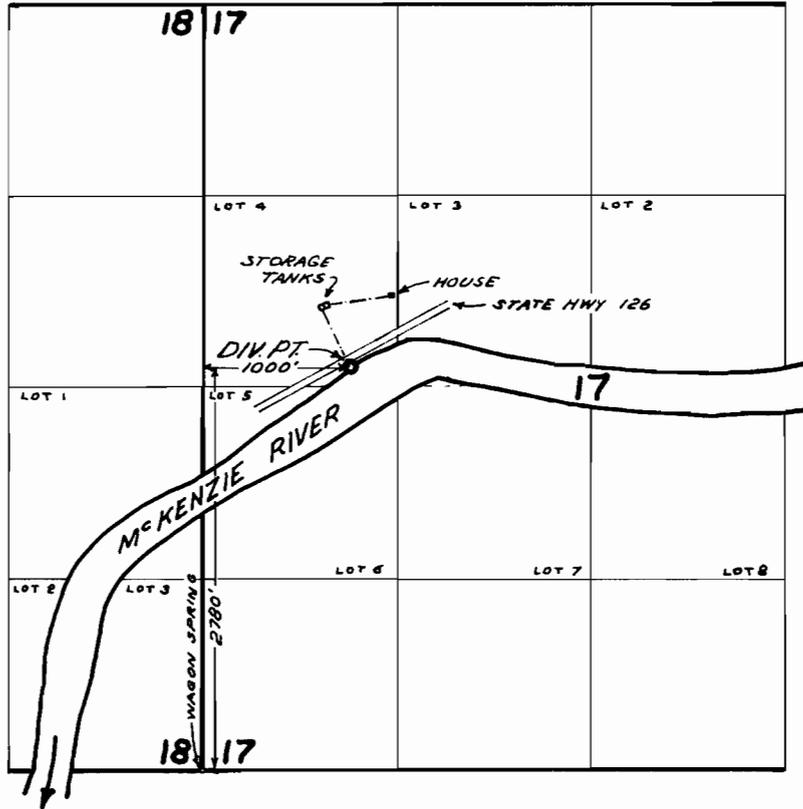

FINAL PROOF SURVEY  
UNDER

Application No. 37424 Permit No. 27870  
IN NAME OF

DUB AND SARAH JANE LASHOT

Surveyed AUG. 29 1966, by L. GOULD