


T.21S.R.2&3W.W.M.

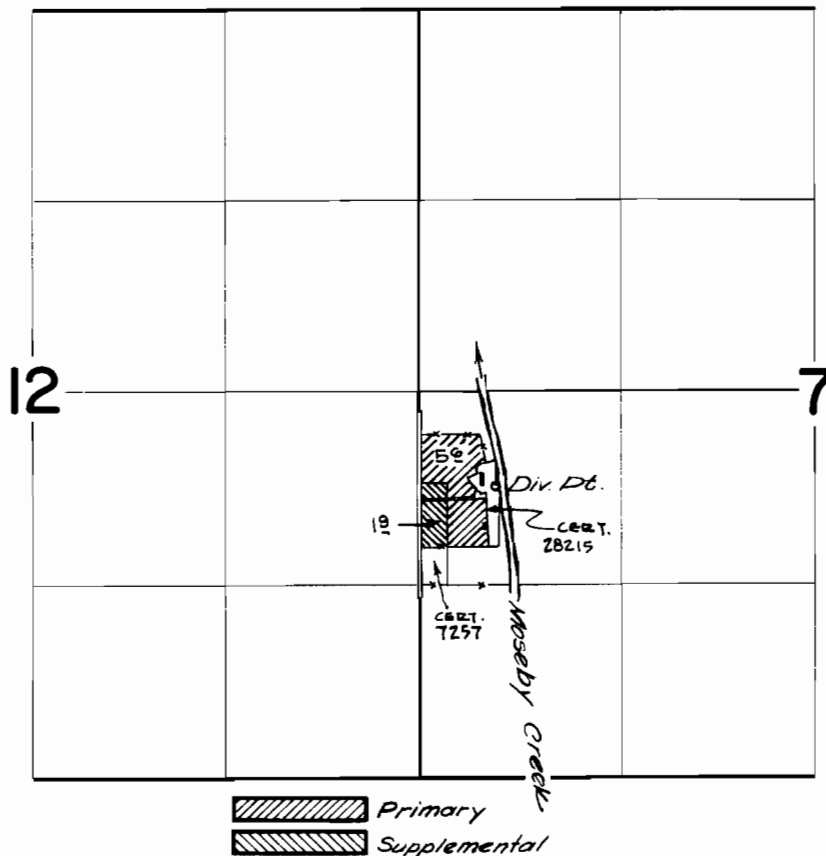

Diversion point is located 670 ft. North and 530 ft. East from SW cor. NW 1/4 SW 1/4

FINAL PROOF SURVEY
UNDER

Application No. **38185** Permit No. **28559**
IN NAME OF

DR. ROBERT B. & EUGENIA MERRICK

Surveyed April 27th 1965, by *R. H. Jackson*